



IN ALL CASES PLOT THE INTENDED WELL ON THE PLAT BELOW

Show the relationship to other wells or facilities proposed to be serviced by the intended cathodic borehole. Please show all the wells, existing cathodic boreholes, pipelines or facilities within 1/2 mile of the proposed borehole.

API NO. 15- \_\_\_\_\_  
 OPERATOR Northern Natural Gas LOCATION OF WELL: COUNTY Seward  
 LEASE Valve 396' feet from South north line of section  
 WELL NUMBER #1 60' feet from East west line of section  
 FACILITY NAME Valve Well #1 SECTION 27 TWP 31S RG 32W

SPOT: QTR/QTR/QTR/QTR OF ACREAGE  
 - SE - SE - SE

IS SECTION X REGULAR or \_\_\_\_\_ IRREGULAR  
IF SECTION IS IRREGULAR, LOCATE WELL FROM NEAREST CORNER BOUNDARY.

Section corner used: \_\_\_\_\_ NE \_\_\_\_\_ NW \_\_\_\_\_ SE \_\_\_\_\_ SW

PLAT

(Show location of intended cathodic borehole.)



(Show footage from nearest lease, unit or outside section boundary line)

**RECEIVED**  
 KANSAS CORPORATION COMMISSION

APR 22 2005

CONSERVATION DIVISION  
 WICHITA KS

Section 27

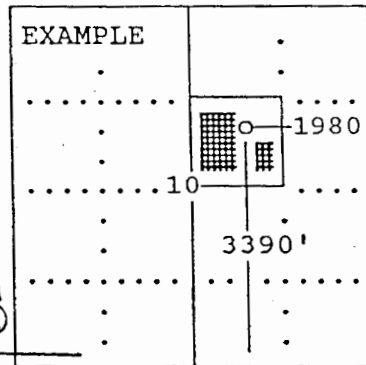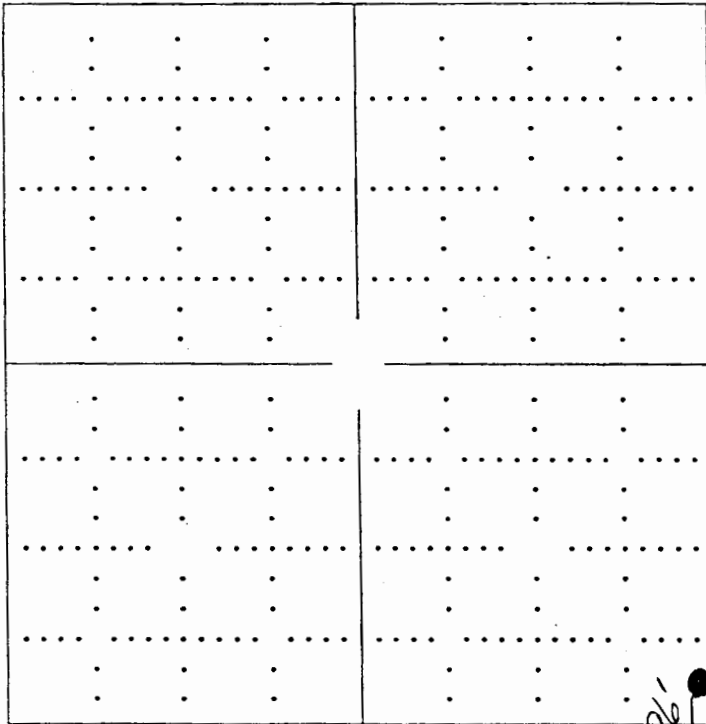

SEWARD CO.

In plotting the proposed location of the well, you must show:

- 1) The manner in which you are using the depicted plat by identifying section lines, i.e. 1 section, 1 section with 8 surrounding sections, 4 sections, etc.;
- 2) the distance of the proposed drilling location from the section's south/north and east/west; and
- 3) the distance to the nearest lease, unit or outside section boundary line.