


STATE OF KANSAS
STATE CORPORATION COMMISSION

15-065-00878-00-00

Give All Information Completely
Make Required Affidavit
Mail or Deliver Report to:
Conservation Division
State Corporation Commission
211 No. Broadway
Wichita, Kansas

WELL PLUGGING RECORD

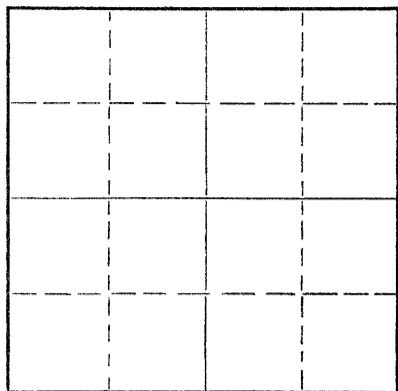

Locate well correctly on above
Section Plat

Graham County. Sec. 16 Twp. 6S Rge. 22W (E) _____ (W) _____
Location as "NE/CNW/SW" or footage from lines NW NW SE
Lease Owner Bankoff Oil Company
Lease Name Broomfield Well No. 1
Office Address P. O. Box 2479, Tulsa, Oklahoma
Character of Well (completed as Oil, Gas or Dry Hole) Dry Hole
Date well completed _____ 5-4-1956
Application for plugging filed _____ 5-4-1956
Application for plugging approved _____ 5-4-1956
Plugging commenced _____ 5-4-1956
Plugging completed _____ 5-4-1956
Reason for abandonment of well or producing formation Dry Hole

If a producing well is abandoned, date of last production _____ 19____
Was permission obtained from the Conservation Division or its agents before plugging was commenced? Yes

Name of Conservation Agent who supervised plugging of this well Eldon R. Petty
Producing formation _____ Depth to top _____ Bottom _____ Total Depth of Well 3934 Feet
Show depth and thickness of all water, oil and gas formations.

OIL, GAS OR WATER RECORDS

CASING RECORD

FORMATION	CONTENT	FROM	TO	SIZE	PUT IN	PULLED OUT
				8 5/8"	344'	

Describe in detail the manner in which the well was plugged, indicating where the mud fluid was placed and the method or methods used in introducing it into the hole. If cement or other plugs were used, state the character of same and depth placed, from _____ feet to _____ feet for each plug set.

Plugged w/rotary mud to 330', 1/2 sk hulls, 20 sks cement. Mud to 40', 1/2 sk hulls, 10 sks cement to surface.

(If additional description is necessary, use BACK of this sheet)

Name of Plugging Contractor Leben Drilling, Inc.
Address 505 Orpheum Bldg, Wichita 2, Kansas

STATE OF KANSAS, COUNTY OF SEDGWICK, ss.
I, James M. Battin (employee of owner) or (~~owner or operator~~) of the above-described well, being first duly sworn on oath, says: That I have knowledge of the facts, statements, and matters herein contained and the log of the above-described well as filed and that the same are true and correct. So help me God.

(Signature) James M. Battin
Wichita, Kansas
(Address)

SUBSCRIBED AND SWORN TO before me this 9th day of May 1956

My commission expires April 20, 1959

Carma D. Mission
Notary Public.

PLUGGING
FILE SEC 16 T 6 R 22W
BOOK 60 LINE 2

RECEIVED
STATE CORPORATION COMMISSION
MAY 10 1956
5-10-56
CONSERVATION DIVISION
Wichita, Kansas