


15-065-00053-00-00

# WELL PLUGGING RECORD

STATE OF KANSAS  
 STATE CORPORATION COMMISSION  
 Give All Information Completely  
 Make Required Affidavit  
 Mail or Deliver Report to:  
 Conservation Division  
 State Corporation Commission  
 800 Biting Building  
 Wichita, Kansas

## FORMATION PLUGGING RECORD

Strike out upper line  
 when reporting plug-  
 ging off formations.

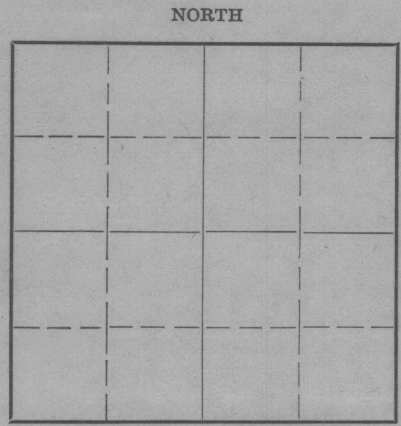

Locate well correctly on above  
 Section Plat

Graham County. Sec. 15 Twp. 6S Rge. 22 (E) W (W)  
 Location as "NE $\frac{1}{4}$ NW $\frac{1}{4}$ SW $\frac{1}{4}$ " or footage from lines SW SW NE  
 Lease Owner Anderson-Prichard and Texon  
 Lease Name F. O. Gudgell "B" Well No. 1  
 Office Address Oklahoma City, Oklahoma  
 Character of Well (completed as Oil, Gas or Dry Hole) Dry hole  
 Date well completed April 28, 1944  
 Application for plugging filed April 27, 1944  
 Application for plugging approved April 27, 1944  
 Plugging commenced April 28, 1944  
 Plugging completed April 28, 1944  
 Reason for abandonment of well or producing formation - -

If a producing well is abandoned, date of last production - - 19      
 Was permission obtained from the Conservation Division or its agents before plugging was com-  
 menced? Yes

Name of Conservation Agent who supervised plugging of this well - -  
 Producing formation      Depth to top      Bottom      Total Depth of Well 3966 Feet  
 Show depth and thickness of all water, oil and gas formations.

### OIL, GAS OR WATER RECORDS

### CASING RECORD

| Formation | Content | From | To | Size  | Put In | Pulled Out |
|-----------|---------|------|----|-------|--------|------------|
|           |         |      |    | 8 5/8 | 295    | None       |
|           |         |      |    |       |        |            |
|           |         |      |    |       |        |            |
Describe in detail the manner in which the well was plugged, indicating where the mud fluid was placed and the method or methods used in introducing it into the hold. If cement or other plugs were used, state the character of same and depth placed, from      feet to      feet for each plug set.

Filled with heavy mud to 295 feet.  
 Bridged hole with wooden plug at 295 feet.  
 Placed 15 sack cement plug on top of  
 bridge. Filled with heavy mud to 30 feet.  
 Bridged hole with wooden plug at 30 feet.  
 Placed 10 sack cement plug on top of bridge.

*pd.*  
 5/11/44  
*Ho,*

**PLUGGING**  
 FILE REC 15 6 220  
 BOOK PAGE 115 LINE 22

STATE OF KANSAS  
 CORPORATION COMMISSION  
 MAY 11 1944  
 CONSERVATION DIVISION  
 OIL FIELD  
 5-11-44

(If additional description is necessary, use BACK of this sheet)  
 Correspondence regarding this well should be addressed to Anderson-Prichard Oil Corporation  
 Address Oklahoma City 2, Oklahoma

STATE OF Oklahoma, COUNTY OF Oklahoma, ss.  
Weston Payne (employee of owner) or (owner or operator) of the above-described well,

being first duly sworn on oath, says: That I have knowledge of the facts, statements, and matters herein contained and the log of the above-described well as filed and that the same are true and correct. So help me God.

(Signature) (WP) Weston Payne

(Address)     , 1944

SUBSCRIBED AND SWORN TO before me this 8th day of May, 1944

My commission expires 8-26-46  
C. L. Norris  
 Notary Public.

Total Depth: 3966'  
Comm: 4/5/44 Comp: 4/28/44

15-065-00093-00-00

Casing  
15 Jts. 8 5/8" Set at 295'

Cement  
135 Sacks

| Formation:                  | Depth: | Formation:                  | Depth: |
|-----------------------------|--------|-----------------------------|--------|
| Shale                       | 65'    | Lime Shale & Pyrite of iron | 2735   |
| Sand                        | 90     | Broken Lime                 | 2815   |
| Shale & Shells              | 315    | Lime Dark                   | 2870   |
| Shale                       | 330    | Lime & Shale                | 2910   |
| Shale & Shells              | 785    | Lime & Shale                | 2965   |
| Shale & Sand                | 900    | Lime & Shale Gray           | 3020   |
| Sand Pyrite of iron & Shale | 1200   | Lime & Shale                | 3095   |
| Sand & Shale Brks           | 1215   | Shale & Lime Brks           | 3177   |
| Shale & Pyrite of Iron      | 1219   | Lime with Shale Brks        | 3228   |
| Sand & Shale Brks.          | 1705   | Broken Lime                 | 3280   |
| Shale & Shells              | 1775   | Lime & Shale                | 3375   |
| Sandy Shale                 | 1790   | Lime Soft                   | 3382   |
| Shale & Shells              | 1940   | Lime                        | 3553   |
| Red Bed Shale & Shells      | 1963   | Lime White Hard             | 3590   |
| Anhydrite                   | 2000   | Lime Hard                   | 3615   |
| Shale & Lime Shells         | 2130   | Lime                        | 3756   |
| Shale Blue & Red            | 2200   | Sandy Shale                 | 3762   |
| Shale & Lime Shells Pyrite  | 2265   | Lime                        | 3773   |
| Shale Lime Shells           | 2325   | Shale                       | 3812   |
| Lime & Shale                | 2355   | Cherty Conglomerate         | 3817   |
| Shale & Lime Shells         | 2420   | Hard Lime                   | 3832   |
| Sand                        | 2430   | Conglomerate Lime           | 3860   |
| Shale & Shells              | 2480   | Conglomerate                | 3905   |
| Shale & Lime Shells         | 2555   | Lime & Conglomerate         | 3942   |
| Shale & Lime                | 2645   | Sandy Shale & Lime          | 3954   |
| Sticky Shale                | 2663   | Conglomerate Hard           | 3966   |

State of Kansas )  
                          ) SS  
Russell County )

I hereby certify that the above information is true and correct to the best of my knowledge.

Ch. Roberts

Subscribed and sworn to before me this 1 day of May, 1944.

Margaret Sutcliffe

Notary Public  
my commission expires April 16, 1947

5-11-44

PLUGGING  
FILE # 15 6-222W  
BOOK PAGE 115 LINE 22

