


STATE OF KANSAS
STATE CORPORATION COMMISSION

15-065-30044-00-00 Form CP-4

WELL PLUGGING RECORD

Give All Information Completely
Make Required Affidavit
Mail or Deliver Report to:
Conservation Division
State Corporation Commission
212 No. Market
Wichita, Kansas

NORTH

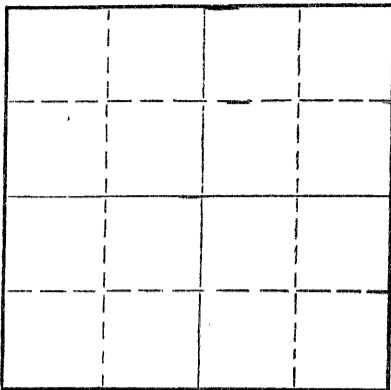

Locate well correctly on above
Section Plat

Location as "NE/CNW/SW" or footage from lines Graham County. Sec. 31 Twp. 6 Rge. 22 (E) (W) x
Lease Owner E. H. Riggs
Lease Name Lacerte Well No. #4
Office Address 350 Denver Club Bldg. Denver, Colo.
Character of Well (completed as Oil, Gas or Dry Hole) _____
Date well completed _____
Application for plugging filed _____ 19____
Application for plugging approved _____ 19____
Plugging commenced _____ 7-18-69 _____ 19____
Plugging completed _____ 7-25-69 _____ 19____
Reason for abandonment of well or producing formation _____

If a producing well is abandoned, date of last production _____ 19____
Was permission obtained from the Conservation Division or its agents before plugging was commenced? _____

Name of Conservation Agent who supervised plugging of this well W. L. Nichols
Producing formation _____ Depth to top _____ Bottom _____ Total Depth of Well 3870' Feet
Show depth and thickness of all water, oil and gas formations.

OIL, GAS OR WATER RECORDS

CASING RECORD

FORMATION	CONTENT	FROM	TO	SIZE	PUT IN	PULLED OUT
				4 1/2"	3869'	837.81'
				7"	222'	

Describe in detail the manner in which the well was plugged, indicating where the mud fluid was placed and the method or methods used in introducing it into the hole. If cement or other plugs were used, state the character of same and depth placed, from _____ feet to _____ feet for each plug set.

Made bottom hole plug back with sand to 3620', mixed and ran 3 sacks cement thru dump bailer.
Squeezed hole with 5 sacks hulls - 14 sacks gel and 65 sacks cement from 1100' to 775'
9 sacks gel from 775' to 250', 15 sacks cement from 250' to 175' - 2 sacks gel from 175' to 50', 10 sacks cement from 50' to base of cellar.

RECEIVED
STATE CORPORATION COMMISSION
AUG 7 1969
CONSERVATION DIVISION
Wichita, Kansas

8-7-69

(If additional description is necessary, use BACK of this sheet)

Name of Plugging Contractor Southwest Casing Pulling Co.
Address Box 364, Great Bend, Kansas


STATE OF Kansas, COUNTY OF Barton, ss.
Southwest Casing Pulling Co. (employee of owner) or (owner or operator) of the above-described

well, being first duly sworn on oath, says: That I have knowledge of the facts, statements, and matters herein contained and the log of the above-described well as filed and that the same are true and correct. So help me God.

(Signature) W. C. Special
Box 364, Great Bend, Kansas
(Address)

SUBSCRIBED AND SWORN TO before me this 26 day of July, 1969

My commission expires October 1972

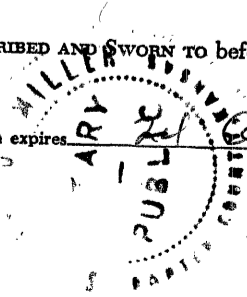

Sidney Miller
Notary Public.