

15-065-19029-00-00


STATE OF KANSAS  
STATE CORPORATION COMMISSION

Give All Information Completely  
Make Required Affidavit  
Mail or Deliver Report to:  
Conservation Division  
State Corporation Commission  
211 No. Broadway  
Wichita, Kansas

WELL PLUGGING RECORD

Graham County, Sec. 31 Twp. 6S. Rge. (E) 22 (W)

Location as "NE/CNW/SW" or footage from lines C SE NW  
Lease Owner Wayne Merchant  
Lease Name Stinemetz Well No. 1  
Office Address 227 Beacon Building, Wichita, Kansas  
Character of Well (completed as Oil, Gas or Dry Hole) Dry Hole  
Date well completed October 6 1964  
Application for plugging filed October 5 1964  
Application for plugging approved October 5 1964  
Plugging commenced October 5 1964  
Plugging completed October 6 1964  
Reason for abandonment of well or producing formation Dry Hole

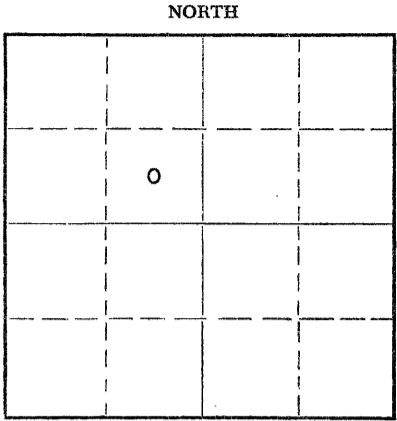

Locate well correctly on above Section Plat

If a producing well is abandoned, date of last production 19  
Was permission obtained from the Conservation Division or its agents before plugging was commenced? Yes

Name of Conservation Agent who supervised plugging of this well W. L. Nichols, Moreland, Kansas  
Producing formation Dry Hole Depth to top Bottom Total Depth of Well 3,756 Feet  
Show depth and thickness of all water, oil and gas formations.

OIL, GAS OR WATER RECORDS

CASING RECORD

FORMATION	CONTENT	FROM	TO	SIZE	PUT IN	PULLED OUT
Surface soil, clay & gravel		0	200	8 5/8	208	NONE

Describe in detail the manner in which the well was plugged, indicating where the mud fluid was placed and the method or methods used in introducing it into the hole. If cement or other plugs were used, state the character of same and depth placed, from feet to feet for each plug set.

- Filled hole with heavy mud cement
- Halliburton plug @ 540, 1/4 sack hulls on top plug and 20 sacks mixed and displaced through the drill pipe
- Filled hole with heavy mud to 180 feet cement
- Halliburton plug @ 180, 1/4 sack hulls on top plug and 20 sacks mixed through the drill pipe
- Filled hole with heavy mud to 40 feet
- Halliburton plug @ 40 feet, 1/2 sack hulls on top plug and 10 sacks cement mixed and displaced through the drill pipe
- Placed 2 sacks cement in rat hole

RECEIVED  
STATE CORPORATION COMMISSION

OCT 13 1964


CONSERVATION DIVISION  
Wichita, Kansas

Name of Plugging Contractor Murfin Drilling Company  
Address 617 Union Center, Wichita, Kansas

STATE OF Kansas, COUNTY OF Sedgwick, ss.  
Wayne Merchant (owner or operator) of the above-described well, being first duly sworn on oath, says: That I have knowledge of the facts, statements, and matters herein contained and the log of the above described well as filed and that the same are true and correct. So help me God.

(Signature) Wayne Merchant  
Wayne Merchant  
227 Beacon Building, Wichita, Kansas  
(Address)

Subscribed and sworn to before me this 7th day of October, 1964

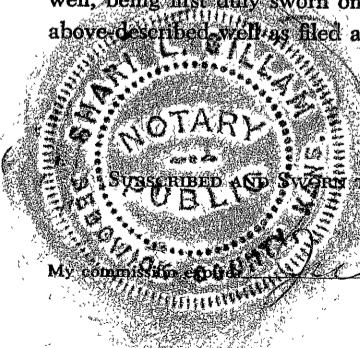

Shari T. Silliam  
Notary Public.

My commission expires July 12, 1967