


15-065-00268-00-00

STATE OF KANSAS
STATE CORPORATION COMMISSION

WELL PLUGGING RECORD

Give All Information Completely
Make Required Affidavit
Mail or Deliver Report to:
Conservation Division
State Corporation Commission
800 Bittling Building
Wichita, Kansas

NORTH

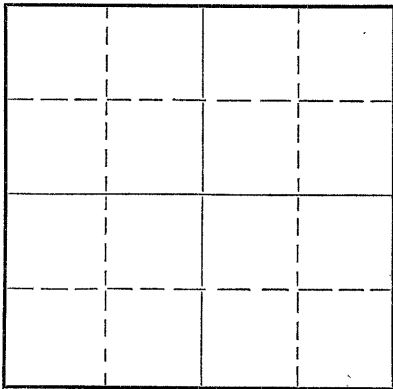

Locate well correctly on above
Section Plat

Graham County, Sec. 31 Twp. 6 Rge. (E) 22 (W)
Location as "NE/CNW¹/₄SW¹/₄" or footage from lines NW¹/₄ NW¹/₄ SW¹/₄
Lease Owner Musgrove Petroleum Corporation
Lease Name Lacerte Well No. 1
Office Address 407 K.F.H. Building, Wichita 2, Kansas
Character of Well (completed as Oil, Gas or Dry Hole) Dry Hole
Date well completed 7/30 19 51
Application for plugging filed 7/30 19 51
Application for plugging approved 7/30 19 51
Plugging commenced 7/30 19 51
Plugging completed 7/30 19 51
Reason for abandonment of well or producing formation Dry

If a producing well is abandoned, date of last production 19
Was permission obtained from the Conservation Division or its agents before plugging was commenced? Yes

Name of Conservation Agent who supervised plugging of this well Mr. Eldon Petty, Hays, Kansas
Producing formation Depth to top Bottom Total Depth of Well 3990 Feet
Show depth and thickness of all water, oil and gas formations. (corrected depth)

OIL, GAS OR WATER RECORDS

CASING RECORD


Formation	Content	From	To	Size	Put In	Pulled Out
				8-5/8"	183'	Cemented

Describe in detail the manner in which the well was plugged, indicating where the mud fluid was placed and the method or methods used in introducing it into the hole. If cement or other plugs were used, state the character of same and depth placed, from feet to feet for each plug set.

Filled hole with heavy mud to 175'.
Set first plug at 175'.
Put in 1/2 sack hulls and 15 sacks cement.
Set second plug at 40'.
Put in 1/2 sack hulls and 10 sacks cement.

(If additional description is necessary, use BACK of this sheet)

Correspondence regarding this well should be addressed to Musgrove Petroleum Corporation
Address 407 K.F.H. Building
Wichita 2, Kansas

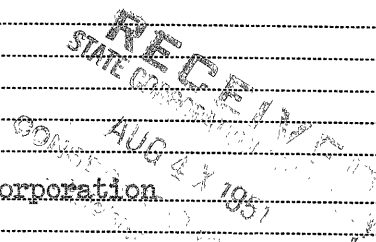

STATE OF KANSAS, COUNTY OF SEDGWICK, ss.
GORDON L. KOELLING (employee of owner) or (owner or operator) of the above-described well,
being first duly sworn on oath, says: That I have knowledge of the facts, statements, and matters herein contained and the log of the above-described well as filed and that the same are true and correct. So help me God.

(Signature) Gordon L. Koelling
407 K.F.H. Building, Wichita 2, Kansas
(Address)

SUBSCRIBED AND SWORN TO before me this 1st day of August, 19 51

Nadine J. Irwin
Notary Public.

My commission expires December 5, 1951

