

15-065-21335-00-00

STATE OF KANSAS
STATE CORPORATION COMMISSION

WELL PLUGGING RECORD

Give All Information Completely
Make Required Affidavit
Mail or Deliver Report to
Conservation Division
State Corporation Comm.
245 North Water
Wichita, KS 67202

Graham County, Sec. 27 Twp. 6S Rge. 22W X/W
Location as "NE/CNW $\frac{1}{4}$ SW $\frac{1}{4}$ " or footage from lines
SW SW NE

Lease Owner ONG Exploration, Inc.
Lease Name Keiswetter Well No. #1

Office Address P.O. Box 871, Tulsa, Oklahoma 74102
Character of Well (Completed as Oil, Gas or Dry Hole)
Dry Hole


Date Well completed December 12 1980
Application for plugging filed December 12 1980
Application for plugging approved December 12 1980
Plugging commenced December 12 1980
Plugging completed December 12 1980

Reason for abandonment of well or producing formation
Dry Hole

If a producing well is abandoned, date of last production
N/A 19

Was permission obtained from the Conservation Division or
its agents before plugging was commenced? Yes

Name of Conservation Agent who supervised plugging of this well Gil Balthazar
Producing formation _____ Depth to top _____ Bottom _____ Total Depth of Well 3778'
Show depth and thickness of all water, oil and gas formations.

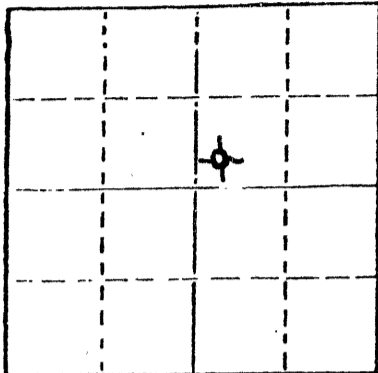

Locate well correctly on above
Section Plat

OIL, GAS OR WATER RECORDS

CASING RECORD

FORMATION	CONTENT	FROM	TO	SIZE	PUT IN	PULLED OUT
Sand				8 5/8"	285'	

Describe in detail the manner in which the well was plugged, indicating where the mud fluid
was placed and the method or methods used in introducing it into the hold. If cement or other
plugs were used, state the character of same and depth placed, from _____ feet to
_____ feet for each plug set.

950'	70 SX					
280'	20 SX					
40'	10 SX					
RH	5 SX					
50 - 50	PAZ	6% gel				

(If additional description is necessary, use BACK of this sheet)

Name of Plugging Contractor _____

STATE OF Kansas COUNTY OF Sedgwick
Paul A. Seymour, Jr. (employee of owner) or owner or operator


of the above-described well, being first duly sworn on oath, says: That I have knowledge of
the facts, statements, and matters herein contained and the log of the above-described well
as filed and that the same are true and correct. So help me God.

(Signature) Paul A. Seymour, Jr.
Paul A. Seymour, Jr., Box 8287-Munger Station
(Address) WICHITA, KS. 67208

SUBSCRIBED AND SWORN TO before me this 18th day of December, 1980

Ruth M. Bassett
Ruth M. Bassett Notary Public.

My commission expires May 30, 1983

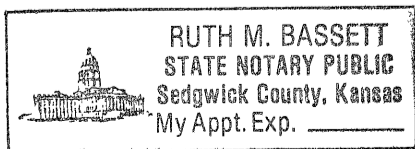

DEC 19 1980
CONSERVATION DIVISION
Wichita, Kansas
SS. 12-19-80