


OR

FORMATION PLUGGING RECORD

Strike out upper line when reporting plugging of formations.

Give All Information Completely
Make Required Affidavit
Mail or Deliver Report to:
Conservation Division
State Corporation Commission
800 Bitting Building
Wichita, Kansas

NORTH

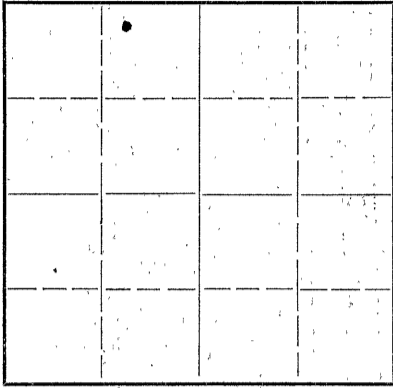

Locate well correctly on above Section Plat

Location as "NE $\frac{1}{4}$ NW $\frac{1}{4}$ SW $\frac{1}{4}$ " or footage from lines 33 6 22 (W)

Lease Owner Maguire Industries Incorporated
Lease Name Stimatso (St. A. Metz) Well No. 1
Office Address 517 Union National Bank Building Wichita 2, Kansas
Character of Well (completed as Oil, Gas or Dry Hole) Dry
Date well completed 1-5-1945
Application for plugging filed 1-4-1945
Application for plugging approved Verbally 1-4-1945
Plugging commenced 1-5-1945
Plugging completed 1-5-1945
Reason for abandonment of well or producing formation Dry

If a producing well is abandoned, date of last production ----- 19-----
Was permission obtained from the Conservation Division or its agents before plugging was commenced? Yes

Name of Conservation Agent who supervised plugging of this well Mr. H.W. Carr
Producing formation ----- Depth to top ----- Bottom ----- Total Depth of Well 4005 Feet
Show depth and thickness of all water, oil and gas formations.

OIL, GAS OR WATER RECORDS

CASING RECORD

Formation	Content	From	To	Size	Put In	Pulled Out
Top: <u>Anhydrite</u>		<u>1992</u>	<u>2017</u>	<u>8-5/8"</u>	<u>308'</u>	<u>None (Cemented)</u>
<u>Dodge</u>		<u>3567</u>				
<u>Lansing</u>		<u>3585</u>				
<u>Artuckle</u>		<u>3954</u>				

Describe in detail the manner in which the well was plugged, indicating where the mud fluid was placed and the method or methods used in introducing it into the hold. If cement or other plugs were used, state the character of same and depth placed, from ----- feet to ----- feet for each plug set.

Hole was filled with heavy mud from total depth of 4005 back up to 300 feet where a bridge was placed at this depth and 15 sacks of cement was placed on same. Hole was then filled with mud back up to within 25 feet of collar base where a bridge was placed at this depth filling up balance of surface pipe and in collar base. (using 10 sacks of cement)

PLUGGING
FILE 33 6 220
BOOK 1 18

(If additional description is necessary, use BACK of this sheet)

Correspondence regarding this well should be addressed to Maguire Industries Incorporated
Address 517 Union National Bank Bld'g. Wichita 2, Kansas

STATE OF Kansas, COUNTY OF Sedgwick, ss.
Gage W. Lee (employee of owner) or (owner or operator) of the above-described well,

being first duly sworn on oath, says: That I have knowledge of the facts, statements, and matters herein contained and the log of the above-described well as filed and that the same are true and correct. So help me God.

(Signature) Gage W. Lee
517 Union National Bank Bld'g. Wichita 2, Kans. (Address)

SUBSCRIBED AND SWORN to before me this 12 day of January, 1945

My commission expires Jan 4, 1947 C. E. Quable Notary Public.

RECD
15-45

15-065-00140-00-00

Maguire Industries Inc.
Stimetre #1 *(Stimetre #2)*

Sec. 33 Twp. 6 Rge. 22
County: Graham, Kansas

Total Depth: 4005'
Comm: 12/2/44 Comp: 1/6/45

Casing
15 Jts. 8 5/8" Set at 308'

Cement
175 Sacks

Formations:	Depth:
Surface soil & shale	80'
Sand	120
Shale & Shells	160
Shale	190
Sand	220
Shale & Shells	308
Shale	410
Shale	560
Sandy Shale	850
Sandy Shale, Shells	1040
Shale & Iron	1100
Shale & Shells	1220
Shale & Sand	1345
Shale & Shells	1435
Red Rock	1730
Shale & Shells	1815
Red Rock	1945
Shale & Shells	1992
Anhydrite	2017
Shale & Shells	2030
Lime & Shale	2120
Shale & Shells	2515
Sandy Lime & Shale	2630
Lime & Shale	3060
Lime	3066
Lime & Shale	3200
Lime	3835
Lime & Shale	3880
Shale & Shells	3908
Cherty Conglomerate	3955
Arbuckle Lime	4005

State of Kansas)
) SS
Russell County)

I hereby certify that the above information is true and correct to the best of my knowledge.

Clara Hummel

Subscribed and sworn to before me this 8th day of January, 1945.

Jessie Poole
Notary Public
My comm. expires 7/2/45

PLUGGING
FILE 33 6 22W
BOOK 1 PAGE 18