

15-065-00035-06-00

STATE OF KANSAS  
STATE CORPORATION COMMISSION

WELL PLUGGING RECORD

OR


FORMATION PLUGGING RECORD

Strike out upper line  
when reporting plug-  
ging of formations.

Give All Information Completely  
Make Required Affidavit  
Mail or Deliver Report to:  
Conservation Division  
State Corporation Commission  
800 Bittling Building  
Wichita, Kansas

Graham County. Sec. 36 Twp. 6 Rge. (E) 25 (W)  
Location as "NE 1/4 NW 1/4 SW 1/4" or footage from lines. SW NE  
Lease Owner. Potash Company of America  
Lease Name. Waggoner Well No. 1  
Office Address. Carlsbad, New Mexico  
Character of Well (completed as Oil, Gas or Dry Hole). Dry hole  
Date well completed. June 23, 1946 19  
Application for plugging filed. June 23, 1946 19  
Application for plugging approved. June 23, 1946 19  
Plugging commenced. June 24, 1946 19  
Plugging completed. June 24, 1946 19  
Reason for abandonment of well or producing formation.

NORTH

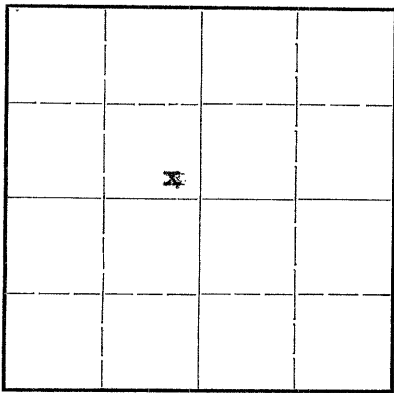

Locate well correctly on above  
Section Plat

If a producing well is abandoned, date of last production. 19  
Was permission obtained from the Conservation Division or its agents before plugging was com-  
menced? yes

Name of Conservation Agent who supervised plugging of this well. Mr. Kerr  
Producing formation. None Depth to top. Bottom. Total Depth of Well. 4287 Feet  
Show depth and thickness of all water, oil and gas formations.


OIL, GAS OR WATER RECORDS

CASING RECORD

Formation	Content	From	To	Size	Put In	Pulled Out
Topeka		3502	3700			
Kansas City lime	dry	3655	4172			
Conglomerate	dry	4172	4237			
Arbuckle	dry	4237	TD	10 3/4"	198'	None

Describe in detail the manner in which the well was plugged, indicating where the mud fluid was placed and the method or methods used in introducing it into the hold. If cement or other plugs were used, state the character of same and depth placed, from feet to feet for each plug set.

Mudded from 4287' to 205', cemented with 20 sacks cement from 205' to 190', mudded from 190' to 10', and cemented with 10 sacks cement to surface.

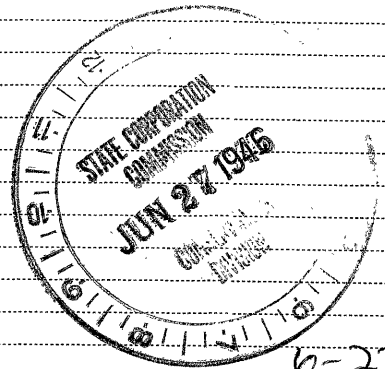

36 6 25W  
60 32

6-27-46

(If additional description is necessary, use BACK of this sheet)

Correspondence regarding this well should be addressed to. Potash Company of America  
Address. Carlsbad, New Mexico

STATE OF Kansas, COUNTY OF Barton, ss.  
R. A. Pierce (employee of owner) or (owner or operator) of the above-described well,  
being first duly sworn on oath, says: That I have knowledge of the facts, statements, and matters herein contained and the log of the above-described well as filed and that the same are true and correct. So help me God

(Signature) *R. A. Pierce*

June 24, 1946 (Address)

SUBSCRIBED AND SWORN to before me this 24 day of June, 1946

*Richard R. Brack*  
Notary Public.

My commission expires March 28, 1949