

15-065-00035-00-00

STATE OF KANSAS
STATE CORPORATION COMMISSION

WELL PLUGGING RECORD

OR

FORMATION PLUGGING RECORD

Strike out upper line
when reporting plugging
off formations.

Give All Information Completely
Make Required Affidavit
Mail or Deliver Report to:
Conservation Division
State Corporation Commission
800 Bitting Building
Wichita, Kansas

Graham County. Sec. 36 Twp. 8 Rge. (E) 25 (W)

Location as "NE $\frac{1}{4}$ NW $\frac{1}{4}$ SW $\frac{1}{4}$ " or footage from lines. 27 33

Lease Owner. Polish Company of America

Lease Name. Waggoner Well No. 1

Office Address. Carlsbad, New Mexico

Character of Well (completed as Oil, Gas or Dry Hole) Dry hole

Date well completed. June 23, 1946 19

Application for plugging filed. June 23, 1946 19

Application for plugging approved. June 23, 1946 19


Plugging commenced. June 24, 1946 19

Plugging completed. June 24, 1946 19

Reason for abandonment of well or producing formation.

If a producing well is abandoned, date of last production 19

Was permission obtained from the Conservation Division or its agents before plugging was commenced? yes

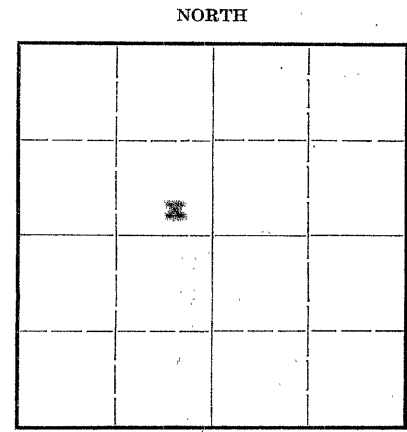

Locate well correctly on above
Section Plat

Name of Conservation Agent who supervised plugging of this well. Mr. Kerr

Producing formation. None Depth to top. Bottom. Total Depth of Well 4287 Feet

Show depth and thickness of all water, oil and gas formations.

OIL, GAS OR WATER RECORDS

CASING RECORD

Top of	Formation	Content	From	To	Size	Put In	Pulled Out
Kansas City line		dry	2544-700	4287-205			
Concrete		dry	4172	4237			
Arbuckle		dry	4287	TD	10 3/4"	198'	None

JUL 5 - 1946
7-546

Describe in detail the manner in which the well was plugged, indicating where the mud fluid was placed and the method or methods used in introducing it into the hole. If cement or other plugs were used, state the character of same and depth placed, from feet to feet for each plug set.

Mudded from 4287' to 205', cemented with 20 sacks cement from 205' to 190', mudded from 190' to 10', and cemented with 10 sacks cement to surface.

I, J. P. Roberts, assistant director, do hereby certify that this is a true and correct copy of the plugging report of the above described well.

J. P. Roberts

Subscribed and sworn to before me on this 5th day of July, 1946.

My commission expires Nov. 5, 1946.

M. Helen Anderson
Notary Public

PLUGGING
FILE : 36 5-R 250
BOOK PAGE 62 LINE 32

(If additional description is necessary, use BACK of this sheet)

Correspondence regarding this well should be addressed to Polish Company of America

Address Carlsbad, New Mexico

STATE OF Kansas, COUNTY OF Graham, ss.

H. A. Pierce

(employee of owner) or (owner or operator) of the above-described well,

being first duly sworn on oath, says: That I have knowledge of the facts, statements, and matters herein contained and the log of the above-described well as filed and that the same are true and correct. So help me God.

(Signature) [Signature]

June 24, 1946 (Address)

SUBSCRIBED AND SWORN to before me this 24 day of June 1946

Richard R. Brack
Notary Public.

My commission expires March 28, 1949