


15-065-20037-00-00

WELL PLUGGING RECORD

Give All Information Completely
Make Required Affidavit
Mail or Deliver Report to:
Conservation Division
State Corporation Commission
212 No. Market
Wichita, Kansas

NORTH

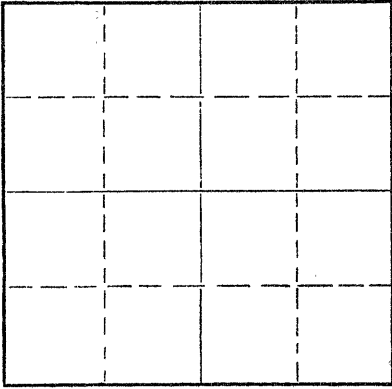

Locate well correctly on above
Section Plat

Graham County. Sec. 31 Twp. 6S Rge. 25W (E) (W)

Location as "NE/CNW/SW" or footage from lines NW NE SW
Lease Owner Okmar Oil Co.

Lease Name Ward Well No. 2

Office Address 1130 Wichita Plaza, Wichita, Kansas 67202

Character of Well (completed as Oil, Gas or Dry Hole) Dry Hole

Date well completed 5-1-67 19

Application for plugging filed 5-1-67 19

Application for plugging approved 5-1-67 19

Plugging commenced 5-1-67 19

Plugging completed 5-1-67 19

Reason for abandonment of well or producing formation Dry Hole

If a producing well is abandoned, date of last production 19

Was permission obtained from the Conservation Division or its agents before plugging was commenced? yes

Name of Conservation Agent who supervised plugging of this well W. L. Nichols

Producing formation Depth to top Bottom Total Depth of Well 2406 Feet

Show depth and thickness of all water, oil and gas formations.

OIL, GAS OR WATER RECORDS

CASING RECORD

FORMATION	CONTENT	FROM	TO	SIZE	PUT IN	PULLED OUT
				8 5/8"	299'	none

Describe in detail the manner in which the well was plugged, indicating where the mud fluid was placed and the method or methods used in introducing it into the hole. If cement or other plugs were used, state the character of same and depth placed, from feet to feet for each plug set.

Bridged hole @ 350' cemented with 25 sks. cement
Bridged Plug @ 295' w/1/2 sk. hulls & 15 sks cement
Mud to 40' set plug w/1/2 sk. hulls 10 sks. cement

RECEIVED
STATE CORPORATION COMMISSION
JUN 5 1967
CONSERVATION DIVISION
WICHITA, KANSAS

6-5-67

(If additional description is necessary, use BACK of this sheet)

Name of Plugging Contractor Leben Drilling, Inc.
Address Box 486, Great Bend, Kansas 67530

STATE OF KANSAS, COUNTY OF BARTON, ss.
Leslie Kite

(employee of owner) or (owner or operator) of the above-described well, being first duly sworn on oath, says: That I have knowledge of the facts, statements, and matters herein contained and the log of the above-described well as filed and that the same are true and correct. So help me God.

(Signature) Leslie Kite

Box 486, Great Bend, Kansas 67530
(Address)

SUBSCRIBED AND SWORN TO before me this 31st day of May, 1967

My commission expires April 1, 1971

Ulanda Nichols
Notary Public.