


19-065-02/26-00-00

STATE OF KANSAS
STATE CORPORATION COMMISSION

Give All Information Completely
Make Required Affidavit
Mail or Deliver Report to:
Conservation Division
State Corporation Commission
211 No. Broadway
Wichita, Kansas

WELL PLUGGING RECORD

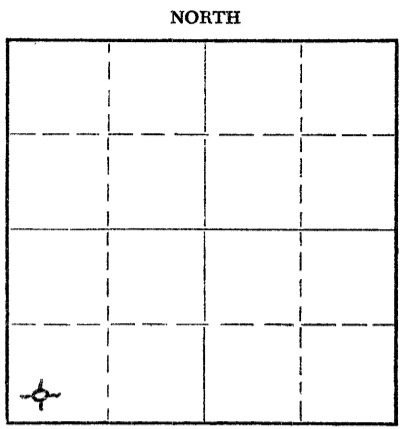

Locate well correctly on above
Section Plat

Graham County. Sec. 32 Twp. 6S Rge. 25(W)
Location as "NE/CNW/SW" or footage from lines SW SW SW
Lease Owner Peel-Hardman Oil Operators
Lease Name Jeffery Well No. 1
Office Address R. R. #3, Box 144B, Wichita 15, Kansas
Character of Well (completed as Oil, Gas or Dry Hole) Dry Hole
Date well completed 6-18 19 59
Application for plugging filed 6-18 19 59
Application for plugging approved 6-18 19 59
Plugging commenced 6-18 19 59
Plugging completed 6-18 19 59
Reason for abandonment of well or producing formation Dry Hole

If a producing well is abandoned, date of last production _____ 19 ____
Was permission obtained from the Conservation Division or its agents before plugging was commenced? Yes

Name of Conservation Agent who supervised plugging of this well A. D. Fabricius
Producing formation _____ Depth to top _____ Bottom _____ Total Depth of Well 3900 Feet
Show depth and thickness of all water, oil and gas formations.

OIL, GAS OR WATER RECORDS

CASING RECORD

FORMATION	CONTENT	FROM	TO	SIZE	PUT IN	PULLED OUT
		0	290	8 5/8"	290'	None

Describe in detail the manner in which the well was plugged, indicating where the mud fluid was placed and the method or methods used in introducing it into the hole. If cement or other plugs were used, state the character of same and depth placed, from _____ feet to _____ feet for each plug set.

- From 3900' to 500' - Heavy Rotary Mud
- " 500' to 498 1/2' - Howco Plug
- " 498 1/2' to 433' - 20 sacks cement
- " 433' to 290' - Heavy Rotary Mud
- " 290' to 288 1/2' - Howco Plug
- " 288 1/2' to 227' - 20 sacks cement
- " 227' to 40' - Heavy Rotary Mud
- " 40' to 38 1/2' - Howco Plug.
- " 38 1/2' to 6' - 10 sacks cement, 1/2 sack hulls
- " 6' to surface - Cellar.

RECEIVED
STATE CORPORATION COMMISSION

JUL 14 1959

CONSERVATION DIVISION
Wichita, Kansas

7-14-59

(If additional description is necessary, use BACK of this sheet)

Name of Plugging Contractor _____
Address _____

STATE OF KANSAS, COUNTY OF SEDGWICK, ss.
William Herbert (employee of owner) or (owner or operator) of the above-described well, being first duly sworn on oath, says: That I have knowledge of the facts, statements, and matters herein contained and the log of the above-described well as filed and that the same are true and correct. So help me God.

(Signature) William Herbert
R. R. #3, Box 144B, Wichita 15, Kansas
(Address)

SUBSCRIBED AND SWORN TO before me this 13th day of July, 19 59

My commission expires March 4, 1962. Manian M. Herbert Notary Public.

PLUGGING
FILE SEC. 32 T. 6 R. 25W
BOOK PAGE 50 LINE 45