


15-065-2 1821-00-00

WELL PLUGGING RECORD

Give All Information Completely  
 Make Required Affidavit

COUNTY Graham SEC. 28 TWP. 6S RGE. 25W X3/4  
 Location as in quarters or footage from lines:  
 NE NE NW

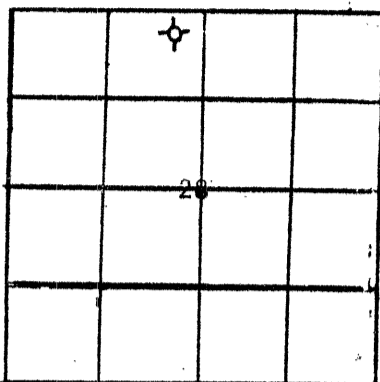

Locate Well  
 correctly on above  
 Section Platt.

Lease Owner Shields Oil Producers, Inc.  
 Lease Name Lindenman "A" Well No. #1  
 Office Address Shields Building, Russell, KS 67665  
 Character of Well (Completed as Oil, Gas or Dry Hole): Dry Hole  
 Date Well Completed August 30, 1983  
 Application for plugging filed Attached  
 Plugging commenced \_\_\_\_\_  
 Plugging completed 4:30 A.M., August 30, 1983  
 Reason for abandonment of well or producing formation \_\_\_\_\_

Was permission obtained from the Conservation Division or it's  
 Agent's before plugging was commenced? Yes

Name of Conservation Agent who supervised plugging of this well Carl Goodrow

Producing formation \_\_\_\_\_ Depth to top \_\_\_\_\_ bottom T.D. 3925'

Show depth and thickness of all water, oil and gas formations.

OIL, GAS OR WATER RECORDS

Casing Record

Formation	Content	From	To	Size	Put in	Pulled Out
				8-5/8"	321'	

Describe in detail the manner in which the well was plugged, indicating where the mud  
 fluid was placed and the method or methods used in introducing it into the hold. If cement  
 or other plugs were used, state the character of same and depth placed, from \_\_\_\_\_ feet  
 to \_\_\_\_\_ feet for each plug set.

- Plug #1 @ 2180' w/20 sks. cement
- Plug #2 @ 1300' w/100 sks. cement
- Plug #3 @ 330' w/40 sks. cement
- Plug #4 @ 40' w/10 sks. cement

10 sks. cement in rathole

RECEIVED  
 STATE CORPORATION COMMISSION

SEP 21 1983

CONSERVATION DIVISION  
 Wichita, Kansas

9-21-83

(If additional description is necessary, use BACK of this sheet)

Name of Plugging Contractor John O. Farmer, Inc.  
P.O. Box 352, Russell, KS 67665

STATE OF Kansas COUNTY OF Russell, ss.

Jack P. Beerman (employee of owner) or (~~owner or operator~~) of the  
 above-described well, being first duly sworn on oath, says: That I have knowledge of the  
 facts, statements, and matters herein contained and the log of the above-described well as  
 filed and that the same are true and correct. So help me God.

(Signature) Jack P. Beerman  
Box 709, Russell, Kansas 67665  
 (Address)

SUBSCRIBED AND SWORN TO before me this 20<sup>th</sup> day of September, 19 83

Anita G. Dole  
 Notary Public.

My Commission expires: 8-20-86

ANITA G. DOLE  
 NOTARY PUBLIC  
 STATE OF KANSAS  
 My Appt. Expires Aug. 20, 1986