


Give All Information Completely  
Make Required Affidavit  
Mail or Deliver Report to:  
Conservation Division  
State Corporation Commission  
211 No. Broadway  
Wichita, Kansas

WELL PLUGGING RECORD

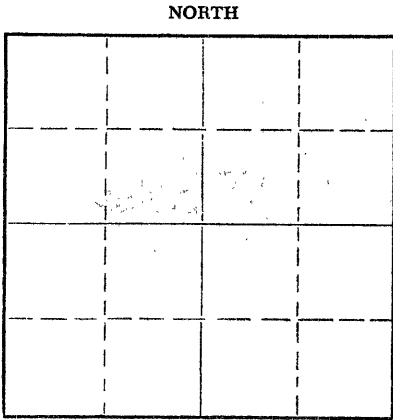

Locate well correctly on above Section Plat

Graham County. Sec. 13 Twp. 6S Rge. 23W (E) (W)  
Location as "NE/CNW&SW&" or footage from lines SE SE NE  
Lease Owner Roger Welty and D & D Drilling Company, Inc.  
Lease Name Rice Well No. 1  
Office Address 307 Schweiter Building, Wichita, Kansas  
Character of Well (completed as Oil, Gas or Dry Hole) Dry Hole  
Date well completed 11-2-65 19\_\_  
Application for plugging filed 11-7-65 19\_\_  
Application for plugging approved 11-2-65 19\_\_  
Plugging commenced 11-2-65 19\_\_  
Plugging completed 11-2-65 19\_\_  
Reason for abandonment of well or producing formation Dry Hole

If a producing well is abandoned, date of last production \_\_\_\_\_ 19\_\_  
Was permission obtained from the Conservation Division or its agents before plugging was commenced? Yes

Name of Conservation Agent who supervised plugging of this well Eldon Petty, Box 325, Hays, Kansas  
Producing formation \_\_\_\_\_ Depth to top \_\_\_\_\_ Bottom \_\_\_\_\_ Total Depth of Well 3840 Feet  
Show depth and thickness of all water, oil and gas formations.

OIL, GAS OR WATER RECORDS

CASING RECORD

FORMATION	CONTENT	FROM	TO	SIZE	PUT IN	PULLED OUT
Surface Hole	8 5/8"	0	233'	8 5/8"	3-23-65	

Describe in detail the manner in which the well was plugged, indicating where the mud fluid was placed and the method or methods used in introducing it into the hole. If cement or other plugs were used, state the character of same and depth placed, from \_\_\_\_\_ feet to \_\_\_\_\_ feet for each plug set.

Set Plug #1 at 550' with 20 sacks cement

Set Plug #2 at 210' with 20 sacks cement

Set Plug #3 at 30' with 10 sacks cement

RECEIVED  
STATE CORPORATION COMMISSION

APR 9 1965  
4-9-65

CONSERVATION DIVISION  
Wichita, Kansas

(If additional description is necessary, use BACK of this sheet)

Name of Plugging Contractor D & D Drilling Company, Inc.  
Address 307 Schweiter Building, Wichita, Kansas

STATE OF Kansas COUNTY OF Sedgwick, ss.  
~~James M. Daniels~~ James R. Daniels

(employee of owner) or (owner or operator) of the above-described well, being first duly sworn on oath, says: That I have knowledge of the facts, statements, and matters herein contained and the log of the above-described well as filed and that the same are true and correct. So help me, God.

(Signature) James R. Daniels  
~~James M. Daniels~~ James R. Daniels  
307 Schweiter Building, Wichita, Kansas  
(Address)

SUBSCRIBED AND SWORN TO before me this 7th day of April, 19 65

My commission expires 11-18-66  
Colleen Chapple Notary Public.