


WELL PLUGGING RECORD 15-065-21755-06-00

Give All Information Completely
 Make Required Affidavit

COUNTY Graham SEC. 36 TWP. 6 RGE. 23W E/W
 Location as in quarters or footage from lines:
SE SE NW

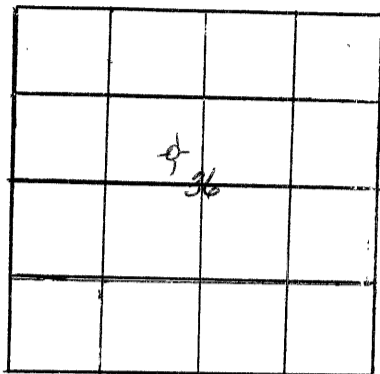

Locate Well
 correctly on above
 Section Platt.

Lease Owner Galloway Drilling Co., Inc.
 Lease Name Worcester Well No. 1
 Office Address 105 S. Broadway, Wichita, KS 67202
 Character of Well (Completed as Oil, Gas or Dry Hole): dry hole
 Date Well Completed 2/1/83
 Application for plugging filed Yes
 Plugging commenced 2/1/83
 Plugging completed 2/1/83
 Reason for abandonment of well or producing formation _____

_____ dry hole
 Was permission obtained from the Conservation Division or it's
 Agent's before plugging was commenced? Yes

Name of Conservation Agent who supervised plugging of this well Marion Schmidt
 Producing formation none Depth to top _____ bottom T.D. 3850'

Show depth and thickness of all water, oil and gas formations.

OIL, GAS OR WATER RECORDS Casing Record

Formation	Content	From	To	Size	Put in	Pulled Out
				8 5/8	258'	None

Describe in detail the manner in which the well was plugged, indicating where the mud fluid was placed and the method or methods used in introducing it into the hold. If cement or other plugs were used, state the character of same and depth placed, from _____ feet to _____ feet for each plug set.

- 1st Plug 2040' w/ 25sx
- 2nd Plug 1200' w/ 100 sx
- 3rd Plug 300' w/40 sx.
- 4th Plug solid bridge 40' w/ 10 sx
- Rat hole w/10sx
- 50-50 Poz + 6% Gel + 3% CC
- Plug down 12:40 p.m. 2/1/83

(If additional description is necessary, use BACK of this sheet)
 Name of Plugging Contractor Allied Cementing, Box 31, Russell, KS

STATE OF Kansas COUNTY OF Sedgwick, ss.
Jay H. Galloway (~~employee of owner~~) or (owner or operator) of the
 above-described well, being first duly sworn on oath, says: That I have knowledge of the
 facts, statements, and matters herein contained and the log of the above-described well as
 filed and that the same are true and correct. So help me God.

(Signature) Jay H. Galloway
Jay H. Galloway, President
105 So. Broadway, Wichita, KS
 (Address)

SUBSCRIBED AND SWORN TO before me this 9th day of February, 1983

EARLENE M. LUMRY
 STATE NOTARY PUBLIC
 SEDGWICK COUNTY, KANSAS
 MY APPT. EXP. _____

Earlene M. Lumry
 Earlene M. Lumry, Notary Public.
 STATE CORPORATION COMMISSION

My Commission expires: Sept 7, 1985

FEB 10 1983