


STATE OF KANSAS
STATE CORPORATION COMMISSION

Give All Information Completely
Make Required Affidavit
Mail or Deliver Report to:
Conservation Division
State Corporation Commission
800 Bitting Building
Wichita, Kansas

15-065-00266-06-00
WELL PLUGGING RECORD

NORTH

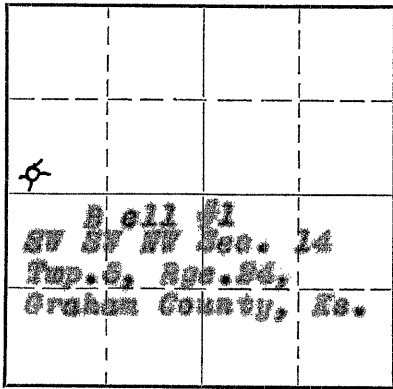

Locate well correctly on above Section Plat

County. Sec. 14 Twp. 6 Rge. 24 (E) 7 (W)
Location as "NE/CNW 1/4 SW 1/4" or footage from lines SW SW SW
Lease Owner Harry Gore
Lease Name Well #1 Well No. #1
Office Address 400 Brown Building, Wichita, Kansas.
Character of Well (completed as Oil, Gas or Dry Hole) Dry Hole
Date well completed 8-1 19 51
Application for plugging filed 8-1 19 51
Application for plugging approved 8-1 19 51
Plugging commenced 8-1 8:00 A.M. 19 51
Plugging completed 8-1 4:00 P.M. 19 51
Reason for abandonment of well or producing formation Dry Hole

If a producing well is abandoned, date of last production 19
Was permission obtained from the Conservation Division or its agents before plugging was commenced? Yes Verbal

Name of Conservation Agent who supervised plugging of this well Eldon Petty
Producing formation Depth to top Bottom Total Depth of Well 4000 Feet
Show depth and thickness of all water, oil and gas formations.

OIL, GAS OR WATER RECORDS

CASING RECORD

Formation	Content	From	To	Size	Put In	Pulled Out
Soil, Clay shales		0'	100'	2 5/8"	100'	none
Lansing K.C.		3000'	3000'		Dry	Dry
Base K.C.		3000'	4170'		Dry	Dry
Arbuckle S.S.		4170'	4000'		Dry	Dry

Describe in detail the manner in which the well was plugged, indicating where the mud fluid was placed and the method or methods used in introducing it into the hole. If cement or other plugs were used, state the character of same and depth placed, from feet to feet for each plug set.

Stirred pits & filled hole with heavy mud. Set bottom mud plug at 100 feet. Put 1/2 sack of shells and bottom plug. Filled with heavy mud to 40 feet. Put 1/2 sack of shells and 10 sacks of cement on top mud plug, filled to bottom of cellar.

RECEIVED
STATE CORPORATION COMMISSION
SEP 7 X 1951
CONSERVATION DIVISION
Wichita, Kansas
9-7-51

(If additional description is necessary, use BACK of this sheet)

Correspondence regarding this well should be addressed to Harry Gore,
Address 400 Brown Building, Wichita, Kansas.

STATE OF Kansas, COUNTY OF Ellis, ss.
F.C. Strain (employee of owner) or (owner or operator) of the above-described well,
being first duly sworn on oath, says: That I have knowledge of the facts, statements, and matters herein contained and the log of the above-described well as filed and that the same are true and correct. So help me God.

(Signature) F.C. Strain

Box 100, Kansas.

SUBSCRIBED AND SWORN to before me this 5 day of September, 19 51

My commission expires July 18, 1955
Notary Public.

23-3273-s 4-50-10M

PLUGGING
FILE SEC 14-6-294
BOOK PAGE 107 LINE 30

WELL LOG

15-065-00266-00-00

COMPANY: Harry Gere.

SW SW NW, Sec. 14,
Twp. 6, Rge. 24,
Graham County, Kansas.

LEASE: Bell # 1.

ELEVATION: 3450 Derrick Floor.

NOTE: All Tops from Rig Floor
3' below Kelly Bushing.

0 5 Cellar
5 130 Clay & shells
130 150 Sand
150 180 Clay & shells
180 192 Root Rock
192 300 Shale
300 300 Shale
300 395 Shale
395 1165 Shale
1165 1300 Sand
1300 1400 Shale & sand
1400 1680 Shale, shells & sand
1680 1750 Shale & shells
1750 1800 Shale & sand
1800 1980 Shale & Redbed
1980 2125 Shale & Redbed
2125 2135 Anhydrite
2135 2165 Anhydrite
2165 2435 Shale & shells
2435 2560 Shale & shells
2560 2720 Shale & Lime
2720 2830 Shale & Lime
2830 2895 Shale & Lime
2895 3020 Lime & shale
3020 3090 Lime & shale
3090 3120 Lime & shale
3120 3225 Shale & Lime
3225 3395 Shale & Lime
3395 3447 Lime & shale
3447 3505 Shale & Lime
3505 3550 Lime & shale
3550 3625 Lime
3625 2675 Lime
3675 3704 Lime
3704 3750 Lime
3750 3790 Lime
3790 3827 Lime
3827 3860 Lime
3860 3885 Lime
3885 3896 Lime
3896 3950 Shale & Lime
3950 3990 Shale & Lime
3990 4020 Lime & shale
4020 4055 Shale & Lime
4055 4100 Lime & shale
4100 4123 Shale
4123 4155 Shale & Lime
4155 4183 Shale & Lime
4183 4212 Chert & Lime
4212 4223 Arbuckle
4223 T.D. (R.B. Head.)

TOPS:

Anhydrite	2135
Topoka	3490
Heebner Shale	3673
Langing K.C.	3699
Base L.C.	3690
Cherty Congl.	4142
Arbuckle	4179
Total Depth.	4223

CASING RECORD:

3 5/8" Surface Casing set at
132 feet w/150 sacks Cement.
By Sun Cementing Co.

San Schlumberger Log to T.D.

COMMENCED: 8-19-51
COMPLETED: 9-1-51

STATE OF KANSAS) SS
COUNTY OF ELLIS)

FILE SEC 14 6 24W
BOOK PAGE 407 LINE 30

I hereby affirm that the above and foregoing is a true and correct copy of the log of the well # 1, located SW SW NW Sec. 14, Twp. 6, Rge. 24, Graham County, Kansas.

RECEIVED
STATE OF KANSAS
CONSERVATION DIVISION
SEP 7 1951 BY T.C. Strain
Strain Drilling Co.

Subscribed and sworn to before me this 5 day of September, 1951.
My Commission expires July 18, 1955.

Delores Ann Fair
NOTARY PUBLIC