

15-065-19032-00-00

STATE OF KANSAS
STATE CORPORATION COMMISSION

Form CP-4

WELL PLUGGING RECORD

Give All Information Completely
Make Required Affidavit
Mail or Deliver Report to:
Conservation Division
State Corporation Commission
211 No. Broadway
Wichita, Kansas

Graham County. Sec. 24 Twp. 6 Rge. 23W (~~22~~) (W)

Location as "NE/CNW&SW&SE" or footage from lines G SW SE

Lease Owner Imperial Oil of Kansas, Inc.

Lease Name Lenney Well No. 51

Office Address 780 4th Nat'l Bldg., Wichita, Kansas

Character of Well (completed as Oil, Gas or Dry Hole) COREHOLE

Date well completed _____ 19____

Application for plugging filed _____ 19____

Application for plugging approved _____ 19____


Plugging commenced _____ 19____

Plugging completed December 14, 1959

Reason for abandonment of well or producing formation _____

If a producing well is abandoned, date of last production _____ 19____

Was permission obtained from the Conservation Division or its agents before plugging was commenced? yes

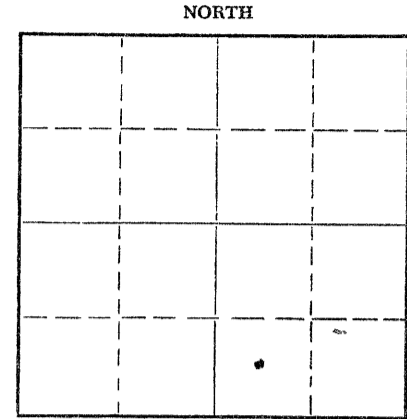

Locate well correctly on above
Section Plat

Name of Conservation Agent who supervised plugging of this well A. D. Fabricius

Producing formation _____ Depth to top _____ Bottom _____ Total Depth of Well 2720' Feet

Show depth and thickness of all water, oil and gas formations.

OIL, GAS OR WATER RECORDS

CASING RECORD

FORMATION	CONTENT	FROM	TO	SIZE	PUT IN	PULLED OUT

Describe in detail the manner in which the well was plugged, indicating where the mud fluid was placed and the method or methods used in introducing it into the hole. If cement or other plugs were used, state the character of same and depth placed, from _____ feet to _____ feet for each plug set.

Mudded back to 300' - 15 sacks cement
Mud to 140' - 15 sacks cement
Mud to 40' - 10 sacks cement
Cement to base of cellar
No surface pipe.

RECEIVED
STATE CORPORATION COMMISSION

FEB 17 1966

CONSERVATION DIVISION
Wichita, Kansas

2-17-66

Name of Plugging Contractor CO. TOOLS
Address _____
(If additional description is necessary, use BACK of this sheet)

STATE OF KANSAS, COUNTY OF Sedgwick, ss.

well, being first duly sworn on oath, says: That I have knowledge of the facts, statements, and matters herein contained and the log of the above-described well as filed and that the same are true and correct. So help me God

(Signature) Marshall Green

780 4th Nat'l Bldg., Wichita, Kansas
(Address)

SUBSCRIBED AND SWORN TO before me this 17th day of February, 1966

My commission expires 11-5-67

Notary Public.