

15-065-00191-06-00


STATE OF KANSAS
STATE CORPORATION COMMISSION

Give All Information Completely
Make Required Affidavit
Mail or Deliver Report to:
Conservation Division
State Corporation Commission
800 Biting Building
Wichita, Kansas

WELL PLUGGING RECORD

Graham County, Sec. 24 Twp. 6 Rge. 23 (E) W (W)
Location as "NE/CNW $\frac{1}{4}$ SW $\frac{1}{4}$ " or footage from lines NW NW SW
Lease Owner Wood River Oil & Refining Co., Inc.
Lease Name Oliver Well No. 1
Office Address 321 W. Doulgas, Wichita, Kansas
Character of Well (completed as Oil, Gas or Dry Hole) Dry Hole
Date well completed February 18, 1951 19
Application for plugging filed February 17, 1951 Verbally 19
Application for plugging approved February 17, 1951 Verbally 19
Plugging commenced February 18, 1951 19
Plugging completed February 18, 1951 19
Reason for abandonment of well or producing formation Dry Hole

NORTH

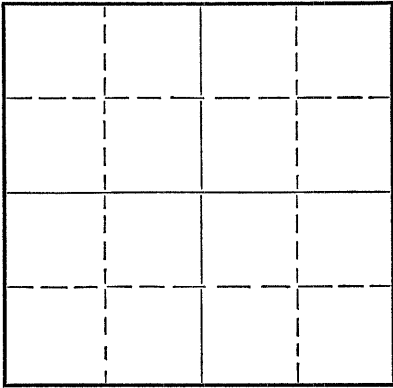

Locate well correctly on above
Section Plat

If a producing well is abandoned, date of last production _____ 19____
Was permission obtained from the Conservation Division or its agents before plugging was commenced? Yes

Name of Conservation Agent who supervised plugging of this well Eldon Petty
Producing formation _____ Depth to top _____ Bottom _____ Total Depth of Well 4005' Feet
Show depth and thickness of all water, oil and gas formations.

OIL, GAS OR WATER RECORDS

CASING RECORD

Formation	Content	From	To	Size	Put In	Pulled Out
				8 5/8"	254'	None

Describe in detail the manner in which the well was plugged, indicating where the mud fluid was placed and the method or methods used in introducing it into the hole. If cement or other plugs were used, state the character of same and depth placed, from _____ feet to _____ feet for each plug set.

Plugging Record

Filled hole with heavy mud to 240'. Put plug in and 1/2 Hulls and 15 sacks cement through drill pipe. Filled hole to 40' and put plug in and 1/2 sack hulls and 10 sacks cement.

RECEIVED
STATE CORPORATION COMMISSION
FEB 24 1951
CONSERVATION DIVISION
Wichita, Kansas

2-24-51

(If additional description is necessary, use BACK of this sheet)

Correspondence regarding this well should be addressed to B & R Drilling, Inc.
Address Russell, Kansas

STATE OF Kansas, COUNTY OF Russell, ss.
W. A. Michaelis, Jr. (employee of owner) or (owner or operator) of the above-described well, being first duly sworn on oath, says: That I have knowledge of the facts, statements, and matters herein contained and the log of the above-described well as filed and that the same are true and correct. So help me God.

(Signature) W. A. Michaelis, Jr.
Russell, Kansas
(Address)

SUBSCRIBED AND SWORN to before me this 22nd day of February, 1951

Chas. L. ...
Notary Public.

My commission expires 6-17-54

23-5091-s 8-50-10M

PLUGGING
FILE SEC 24 T 6 R 3 W
BOOK 63 LINE 34