

15-065-00269-00-00

STATE OF KANSAS  
STATE CORPORATION COMMISSION


WELL PLUGGING RECORD

Give All Information Completely  
Make Required Affidavit  
Mail or Deliver Report to:  
Conservation Division  
State Corporation Commission  
800 Bitting Building  
Wichita, Kansas

Graham

County. Sec. 28 Twp. 6 Rge. (E) 25 (W)

NORTH

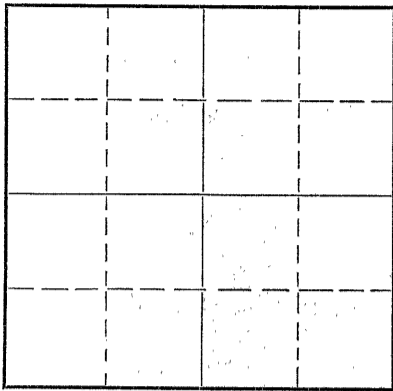

Locate well correctly on above  
Section Plat

Location as "NE/CNW $\frac{1}{4}$ SW $\frac{1}{4}$ " or footage from lines NE NE NE  
Lease Owner Harry Gore  
Lease Name Cook Well No. 1  
Office Address 400 Brown Bldg., Wichita, Kansas  
Character of Well (completed as Oil, Gas or Dry Hole) Dry Hole  
Date well completed 7-7-51 19  
Application for plugging filed 7-7-51 19  
Application for plugging approved 7-7-51 19  
Plugging commenced 7-7-51 19  
Plugging completed 7-7-51 19  
Reason for abandonment of well or producing formation

If a producing well is abandoned, date of last production 19  
Was permission obtained from the Conservation Division or its agents before plugging was commenced? Yes

Name of Conservation Agent who supervised plugging of this well Eldon Petty Hays, Kansas  
Producing formation Depth to top Bottom Total Depth of Well 4250 Feet  
Show depth and thickness of all water, oil and gas formations.

OIL, GAS OR WATER RECORDS

CASING RECORD

Formation	Content	From	To	Size	Put In	Pulled Out
				<u>8-5/8"</u>	<u>280'</u>	<u>Cemented</u>

Describe in detail the manner in which the well was plugged, indicating where the mud fluid was placed and the method or methods used in introducing it into the hole. If cement or other plugs were used, state the character of same and depth placed, from feet to feet for each plug set.

Filled hole to 250' with heavy mud. Run plug and 1/2 sack of cotton seed hulls and 15 sacks of cement. Filled hole to 40' with heavy mud and put plug and 1/2 sack of cotton seed hulls and 10 sacks of cement.

RECEIVED  
STATE CORPORATION COMMISSION  
JUL 20 1951  
CONSERVATION DIVISION

(If additional description is necessary, use BACK of this sheet)  
Correspondence regarding this well should be addressed to Harry Gore  
Address 400 Brown Bldg. Wichita, Kansas 17-20-51

STATE OF KANSAS, COUNTY OF MONTGOMERY, ss.  
FLOYD W. HILD (employee of owner) or (owner or operator) of the above-described well,  
being first duly sworn on oath, says: That I have knowledge of the facts, statements, and matters herein contained and the log of the above-described well as filed and that the same are true and correct. So help me God. THE VEEDER SUPPLY & DEVELOPMENT COMPANY

(Signature) Floyd W. Hild  
P. O. Box 201, Cherryvale, Kansas  
(Address)

SUBSCRIBED AND SWORN to before me this 17th day of July, 19 51  
Olus Lawson  
Notary Public.

My commission expires July 11, 1952

PLUGGING  
FILE SEC 26 T 6 R 25W  
BOOK PAGE 92 LINE 44