

15-179-05612-00-00

STATE OF KANSAS  
STATE CORPORATION COMMISSION


WELL PLUGGING RECORD

Give All Information Completely  
Make Required Affidavit  
Mail or Deliver Report to:  
Conservation Division  
State Corporation Commission  
800 Bitting Building  
Wichita, Kansas

OR  
FORMATION PLUGGING RECORD

Strike out upper line  
when reporting plug-  
ging off formations.

Sheridan County. Sec. 18 Twp. 6S Rge. 26WE (W)  
Location as "NE 1/4 NW 1/4 SW 1/4" or footage from lines. C N/2 NW SW  
Lease Owner. Imperial Oil of Kansas, Inc.  
Lease Name Hardesty Well No. 1  
Office Address. 780 Fourth National Bldg., Wichita 2, Kansas  
Character of Well (completed as Oil, Gas or Dry Hole) Dry Hole  
Date well completed. October 16, 1958  
Application for plugging filed. October 16, 1958  
Application for plugging approved. October 16, 1958  
Plugging commenced. October 16, 1958  
Plugging completed. October 16, 1958  
Reason for abandonment of well or producing formation. No commercial quantities  
of oil found.  
If a producing well is abandoned, date of last production. 19  
Was permission obtained from the Conservation Division or its agents before plugging was com-  
menced? Yes

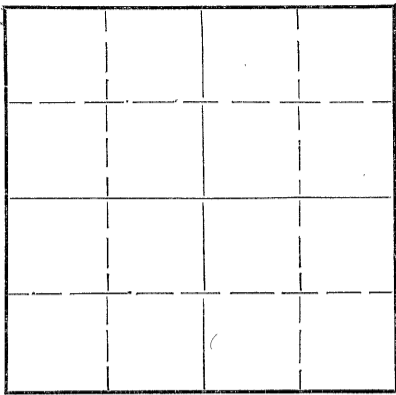

Locate well correctly on above  
Section Plat

Name of Conservation Agent who supervised plugging of this well. Mr. A. D. Fabricius  
Producing formation. Depth to top. Bottom. Total Depth of Well. 3870 Feet  
Show depth and thickness of all water, oil and gas formations.


OIL, GAS OR WATER RECORDS

CASING RECORD

Formation	Content	From	To	Size	Put In	Pulled Out
				8-5/8"	215'	215'

Describe in detail the manner in which the well was plugged, indicating where the mud fluid was placed and the method or methods used in introducing it into the hole. If cement or other plugs were used, state the character of same and depth placed, from.....feet to .....feet for each plug set.

Set No. 1 Plug at 600' with  
25 sacks cement. Set No. 2  
Plug at 200' with 15 sacks  
cement. Set No. 3 Plug at  
40' with 10 sacks cement.

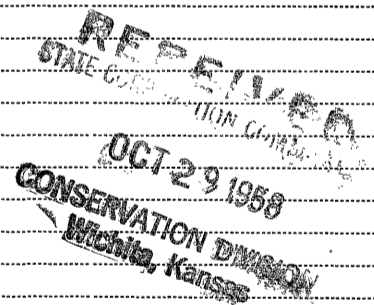

(If additional description is necessary, use BACK of this sheet)  
Correspondence regarding this well should be addressed to Imperial Oil of Kansas, Inc. 10-29-58  
Address. 780 Fourth National Bldg., Wichita 2, Kansas

STATE OF KANSAS, COUNTY OF SEDGWICK, ss.  
Raymond L. Bacon (employee of ~~Imperial Oil of Kansas, Inc.~~) of the above-described well,

being first duly sworn on oath, says: That I have knowledge of the facts, statements, and matters herein contained and the log of the above-described well as filed and that the same are true and correct. So help me God. IMPERIAL OIL OF KANSAS, INC.

(Signature) By: *Raymond L. Bacon* V-P.

780 Fourth National Building, Wichita 2, Kansas  
(Address)

SUBSCRIBED AND SWORN to before me this 28th day of October, 1958

*Mona L. Latier*  
Mona L. Latier Notary Public.

My commission expires July 7, 1962

22-2625 2-48-14M

