

15-179-20066-00-00

STATE OF KANSAS
STATE CORPORATION COMMISSION


Form CP-4

Give All Information Completely
Make Required Affidavit
Mail or Deliver Report to:
Conservation Division
State Corporation Commission
212 No. Market
Wichita, Kansas

WELL PLUGGING RECORD

Sheridan - Kansas County. Sec. 1 Twp. 6S Rge. (E) 26 (W)
Location as "NE/CNW $\frac{1}{4}$ SW $\frac{1}{4}$ " or footage from lines. C NE NE
Lease Owner Murfin Et Al
Lease Name SLIPKE Well No. ONE
Office Address 617 Union Center Wichita, Kansas 67202
Character of Well (completed as Oil, Gas or Dry Hole) Dry Hole
Date well completed 12-30-67
Application for plugging filed 12-30-67
Application for plugging approved 12-30-67
Plugging commenced 12-30-67
Plugging completed 12-30-67
Reason for abandonment of well or producing formation Dry Hole

NORTH

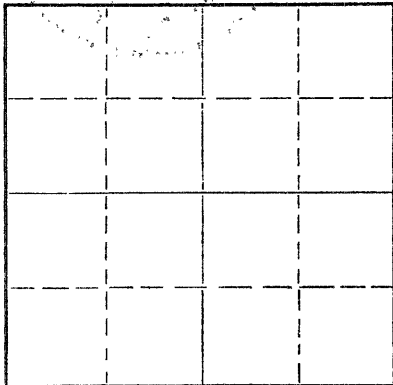

Locate well correctly on above
Section Plat

If a producing well is abandoned, date of last production 19
Was permission obtained from the Conservation Division or its agents before plugging was commenced? yes

Name of Conservation Agent who supervised plugging of this well W. L. Nichols / Moreland, Kansas
Producing formation Depth to top Bottom Total Depth of Well 4110 Feet
Show depth and thickness of all water, oil and gas formations.

OIL, GAS OR WATER RECORDS

CASING RECORD

FORMATION	CONTENT	FROM	TO	SIZE	PUT IN	PULLED OUT

Describe in detail the manner in which the well was plugged, indicating where the mud fluid was placed and the method or methods used in introducing it into the hole. If cement or other plugs were used, state the character of same and depth placed, from feet to feet for each plug set.

1st plug @ 1251 w/100 sks
2nd plug @ 240 w/20 sks
3rd plug @ 40 w/10 sks

RECEIVED
STATE CORPORATION COMMISSION
JAN 15 1968
CONSERVATION DIVISION
Wichita, Kansas

1-15-68


(If additional description is necessary, use BACK of this sheet)

Name of Plugging Contractor Murfin Drilling Company
Address 617 Union Center - Wichita, Kansas 67202

STATE OF KANSAS, COUNTY OF SEDGWICK, ss.
James R. Daniels (employee of owner) or (owner or operator) of the above-described well, being first duly sworn on oath, says: That I have knowledge of the facts, statements, and matters herein contained and the log of the above-described well as filed and that the same are true and correct. So help me God.

(Signature) MURFIN DRILLING COMPANY
James R. Daniels (Address)

SUBSCRIBED AND SWORN to before me this 12th day of January, 1968

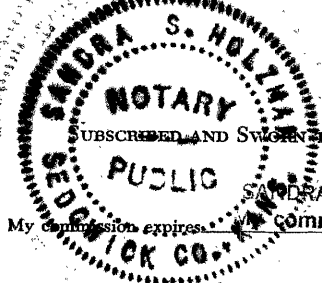

Sandra S. Holzman, Notary Public
My commission expires March 4, 1968

Notary Public.