

15-179-30082-00-00

STATE OF KANSAS
STATE CORPORATION COMMISSION

Form CP-4


Give All Information Completely
Make Required Affidavit
Mail or Deliver Report to:
Conservation Division,
State Corporation Commission
212 No. Market
Wichita, Kansas 67202

WELL PLUGGING RECORD

Sheridan County, Sec. 22 Twp. 6 Rge. 26 (E) (W) x

Location as "NE/CNW/SW" or footage from lines NW NW SW
Lease Owner Okmar Oil Co.
Lease Name Mowry Well No. #1
Office Address 1130 Vickers KSB&T Bldg., Wichita, Kansas 67202
Character of Well (completed as Oil, Gas or Dry Hole)
Date well completed 19
Application for plugging filed 10-20-70 19
Application for plugging approved 19
Plugging commenced 11-25-70 19
Plugging completed 12-1-70 19
Reason for abandonment of well or producing formation

If a producing well is abandoned, date of last production 19
Was permission obtained from the Conservation Division or its agents before plugging was commenced?

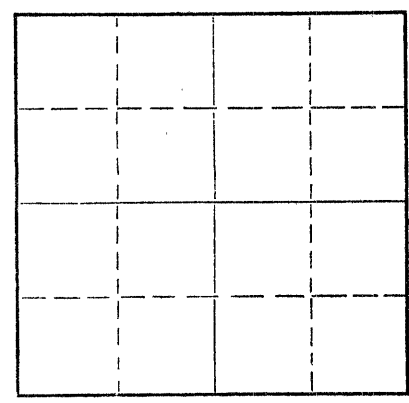

Locate well correctly on above Section Plat

Name of Conservation Agent who supervised plugging of this well W. L. Nichols
Producing formation Depth to top Bottom Total Depth of Well 3940' Feet
Show depth and thickness of all water, oil and gas formations.

OIL, GAS OR WATER RECORDS

CASING RECORD

FORMATION	CONTENT	FROM	TO	SIZE	PUT IN	PULLED OUT
				4 1/2"	3939'	1335.57'
				7"	359'	

Describe in detail the manner in which the well was plugged, indicating where the mud fluid was placed and the method or methods used in introducing it into the hole. If cement or other plugs were used, state the character of same and depth placed, from feet to feet for each plug set.

Pushed plug to 3700'. Sanded from 3700' to 3650'. Mixed and ran 3 sacks cement thru dump bailer.
Squeezed hole with 5 sacks hulls - 8 sacks gel - followed with 75 sacks cement.
Cement from 1300' to 975', followed with 12 sacks gel. Gel from 975' to 375', followed with 20 sacks cement. Cement from 375' to 275', followed with 5 sacks gel, gel from 275' to 50'. Displaced with 10 sacks cement. Cement from 50' to base of cellar.

RECEIVED
STATE CORPORATION COMMISSION
DEC 3 - 1970
CONSERVATION DIVISION
Wichita, Kansas

12-3-70

(If additional description is necessary, use BACK of this sheet)

Name of Plugging Contractor Southwest Casing Pulling Co.
Address Box 364, Great Bend, Kansas

STATE OF Kansas, COUNTY OF Barton, ss.
Southwest Casing Pulling Co. (employee of owner) or (owner or operator) of the above-described well, being first duly sworn on oath, says: That I have knowledge of the facts, statements, and matters herein contained and the log of the above-described well as filed and that the same are true and correct. So help me God.

(Signature) W. C. Spencer
Box 364, Great Bend, Kansas
(Address)

SUBSCRIBED AND SWORN TO before me this 2 day of December, 1970

My commission expires December 1972

Sidney D. Weller
Notary Public.

