


15-179-20522-00-00

STATE OF KANSAS
STATE CORPORATION COMMISSION

Give All Information Completely
Make Required Affidavit
Mail or Deliver Report to:
Conservation Division
State Corporation Commission
212 North Market, Insurance Bldg.
Wichita, Kansas

WELL PLUGGING RECORD

NORTH

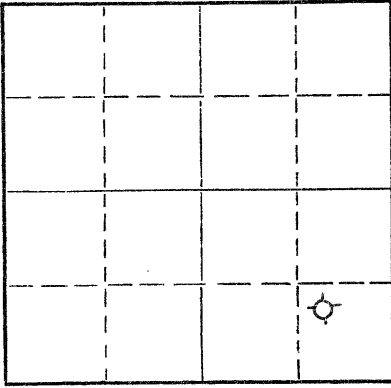

Locate well correctly on above
Section Plat

Sheridan County, Sec. 21 Twp. 6S Rge. 26W (E) (W)
Location as "NE/CNW/SW" or footage from lines NW SE SE
Lease Owner Thomlinson Oil Company Thomlinson Oil Co.
Lease Name Wudke Well No. #1
Office Address Suite 1030 200 West Douglas Wichita, Kansas 67202
Character of Well (completed as Oil, Gas or Dry Hole) Dry Hole
Date well completed 10-19-78 19
Application for plugging filed Yes 19
Application for plugging approved 19
Plugging commenced 12:50 P. M. 10-19-78 19
Plugging completed 19
Reason for abandonment of well or producing formation _____

If a producing well is abandoned, date of last production _____ 19
Was permission obtained from the Conservation Division or its agents before plugging was commenced? Yes

Name of Conservation Agent who supervised plugging of this well Gilbert Balthazor
Producing formation _____ Depth to top _____ Bottom _____ Total Depth of Well _____ Feet
Show depth and thickness of all water, oil and gas formations.


OIL, GAS OR WATER RECORDS

CASING RECORD

FORMATION	CONTENT	FROM	TO	SIZE	PUT IN	PULLED OUT

Describe in detail the manner in which the well was plugged, indicating where the mud fluid was placed and the method or methods used in introducing it into the hole. If cement or other plugs were used, state the character of same and depth placed, from _____ feet to _____ feet for each plug set.

Plug #1 1250'/w 70 sxs. cement
Plug #2 300'/w 20 sxs. cement
Plug #3 40'/w 10 sxs. cement

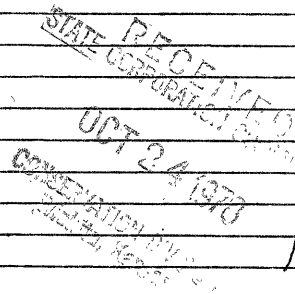

10-24-78


(If additional description is necessary, use BACK of this sheet)

Name of Plugging Contractor John O. Farmer, Inc.
Address Box 352 Russell, Kansas 67665

STATE OF Kansas, COUNTY OF Russell, ss.
John O. Farmer, III (employee of owner) or (owner or operator) of the above-described well, being first duly sworn on oath, says: That I have knowledge of the facts, statements, and matters herein contained and the log of the above-described well as filed and that the same are true and correct. So help me God.

(Signature) John O. Farmer III
Box 352 Russell, Kansas 67665
(Address)

SUBSCRIBED AND SWORN to before me this 23rd day of October, 1978

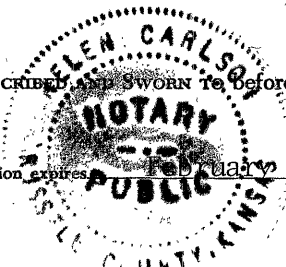

My commission expires February 15, 1979
Helen Carlson Notary Public.