


15-179-20416-00-00

STATE OF KANSAS
STATE CORPORATION COMMISSION
CONSERVATION DIVISION
P. O. BOX 17027
WICHITA, KANSAS 67217

FORM CP-4

WELL PLUGGING RECORD

Sheridan County, Sec 22 Twp 6S Rge 26W (E) (W)
Location as "NE/CNW/SW" or footage from lines NE NE NE
Lease Owner Ferguson Oil & Gas Co., Inc.
Lease Name Twell Well No 1
Office Address 2700 Liberty Tower; Oklahoma City, Okla. 73102
Character of Well (completed as Oil, Gas or Dry Hole) Dry Hole
Date well completed January 13, 1976
Application for plugging filed January 12, 1976
Application for plugging approved January 12, 1976
Plugging commenced January 13, 1976
Plugging completed January 13, 1976
Reason for abandonment of well or producing formation D&A

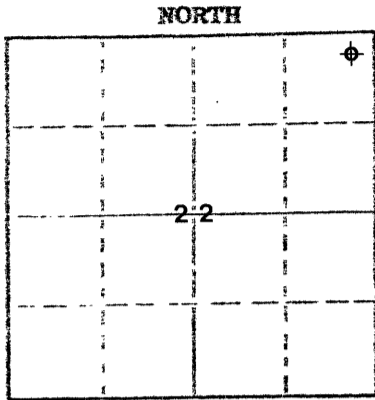

Locate well correctly on above Section Plot

If a producing well is abandoned, date of last production 19
Was permission obtained from the Conservation Division or its agents before plugging was commenced? yes

Name of Conservation Agent who supervised plugging of this well W. I. Nichols
Producing formation _____ Depth to top _____ Bottom _____ Total Depth of Well 3940 Feet
Show depth and thickness of all water, oil and gas formations.

OIL, GAS OR WATER RECORDS

CASING RECORD

FORMATION	CONTENT	FROM	TO	SIZE	PUT IN	PULLED OUT
				8 5/8"	341.52'	-0-

Describe in detail the manner in which the well was plugged, indicating where the mud fluid was placed and the method or methods used in introducing it into the bore. If cement or other plugs were used, state the character of same and depth placed, from _____ feet to _____ feet for each plug set.

Plug @ 1200' w/70 sx
Plug @ 300' w/20 sx
Plug @ 40' w/10 sx
Cemented w/50-50 Poz Mix

(If additional description is necessary, use BACK of this sheet)

1-23-76

Name of Plugging Contractor Red Tiger Drilling Co.
Address 1720 Wichita Plaza, Wichita, Ks. 67202

STATE OF Kansas COUNTY OF Sedgwick, ss.
Jean Stocks (employee of owner) or (owner or operator) of the above-described well, being first duly sworn on oath, says: That I have knowledge of the facts, statements, and matters herein contained and the log of the above-described well as filed and that the same are true and correct. So help me God.

(Signature) Jean Stocks
1720 Wichita Plaza, Wichita, Ks. 67202
(Address)

SUBSCRIBED AND SWORN TO before me this 15th day of January, 1976

My commission expires _____

D'Ann Drennan
Notary Public

