

15-179-00114-00-00

STATE OF KANSAS
STATE CORPORATION COMMISSION

WELL PLUGGING RECORD

Give All Information Completely
Make Required Affidavit
Mail or Deliver Report to:
Conservation Division
State Corporation Commission
800 Bittling Building
Wichita, Kansas

Sheridan County. Sec. 22 Twp. 6 Rge. 26 (E) (W)

Location as "NE/CNW%SW%" or footage from lines SE SE NW

Lease Owner Logan and Shoemaker Sauvage + Dunn

Lease Name Showers Well No. 1

Office Address Decatur, Kansas

Character of Well (completed as Oil, Gas or Dry Hole) dry hole

Date well completed 6-27 19 55

Application for plugging filed 6-27 19 55

Application for plugging approved 6-28 19 55


Plugging commenced 6-28 19 55

Plugging completed 6-28 19 55

Reason for abandonment of well or producing formation dry hole

If a producing well is abandoned, date of last production 19

Was permission obtained from the Conservation Division or its agents before plugging was commenced? yes

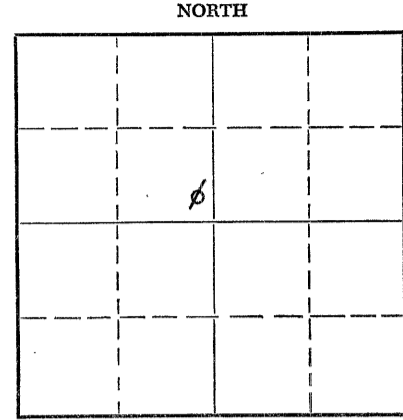

Locate well correctly on above Section Flat

Name of Conservation Agent who supervised plugging of this well Eldon Petty

Producing formation _____ Depth to top _____ Bottom _____ Total Depth of Well 4256 Feet

Show depth and thickness of all water, oil and gas formations.

OIL, GAS OR WATER RECORDS

CASING RECORD

FORMATION	CONTENT	FROM	TO	SIZE	PUT IN	PULLED OUT
				8-5/8"	315	None

Describe in detail the manner in which the well was plugged, indicating where the mud fluid was placed and the method or methods used in introducing it into the hole. If cement or other plugs were used, state the character of same and depth placed, from _____ feet to _____ feet for each plug set.

Filled hole with heavy mud thru drill pipe pulled the pipe to 300 feet set plug mixed 1/2 sx hulls and 15 sx cement filled the hole with heavy mud and set plug at 40 feet mixed 1/2 sx hulls and 10 sx cement. Filled hole to bottom of cellar.

(If additional description is necessary, use BACK of this sheet)

Name of Plugging Contractor Sauvage + Dunn Drilling Co., Inc.

Address Oberlin, Kansas

STATE OF Kansas, COUNTY OF Decatur, ss.

_____, (employee of owner) or (owner or operator) of the above-described well, being first duly sworn on oath, says: That I have knowledge of the facts, statements, and matters herein contained and the log of the above-described well as filed and that the same are true and correct. So help me God.

(Signature) [Signature]

Oberlin, Kansas (Address)

SUBSCRIBED AND SWORN TO before me this 30th day of June, 19 55

My commission expires May 17, 1959

[Signature] Notary Public.

24-7368-S 3-53-20M

PLUGGING
FILE SEC. 22 T. 6 R. 26W
BOOK PAGE 131 LINE 4

7-7-55