

15-065-22317-00-00

PLAT AND CERTIFICATION OF ACREAGE ATTRIBUTABLE TO AN OIL WELL

State Corporation Commission, Conservation Division  
200 Colorado Derby Bldg. Wichita, Kansas 67202

OPERATOR PANCANADIAN PETROLEUM COMPANY

LOCATION OF WELL:

LEASE BETHELL

1980' feet from the South line  
1980' feet from the West line

WELL NUMBER 23-17 No. 3

Of the SW/4 of Sec 17 T. 6S R. 22W

FIELD Penn



COUNTY Graham

\*NUMBER OF ACRES  
ATTRIBUTABLE TO WELL 40

DESCRIPTION OF ACREAGE:  
NE/4 of the SW/4 Section 17

P L A T

(Show location of Well and outline attributable acreage)  
(Show footage to nearest lease or unit boundry line)

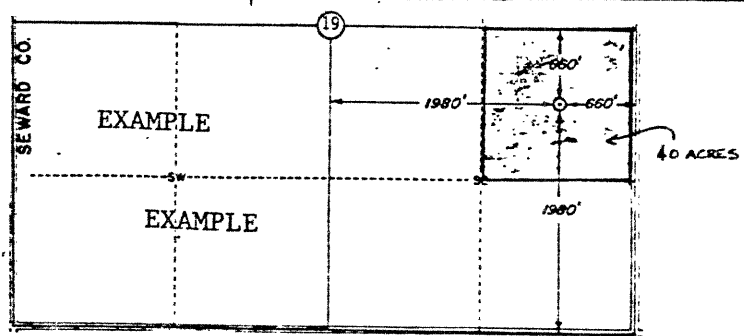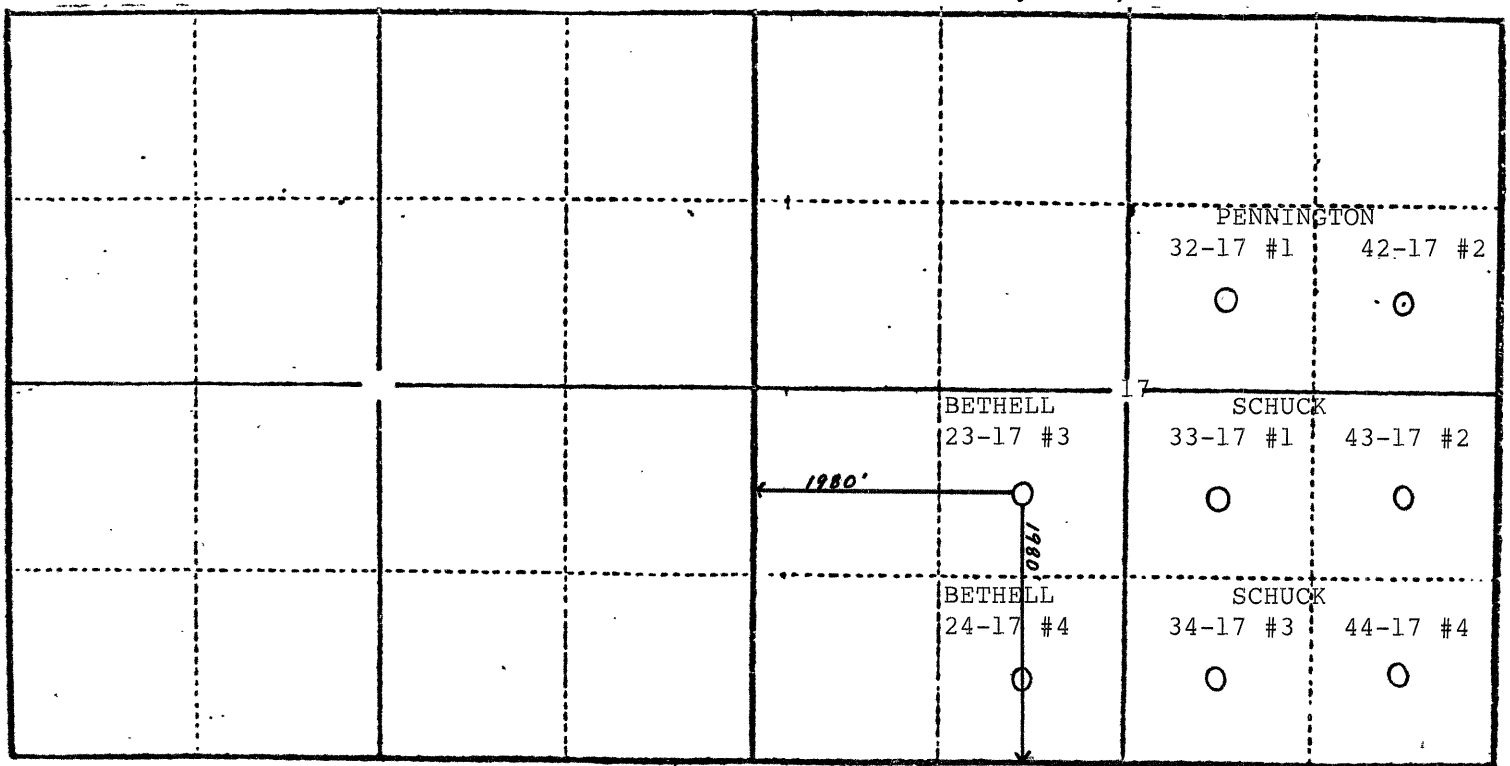

The undersigned hereby certifies that he is Coord., Eng. Operations U.S.  
for PANCANADIAN PETROLEUM COMPANY, a duly authorized agent, that all information  
shown hereon is true and correct to the best of his knowledge and belief, and that  
all acreage claimed as attributable to the well named herein is held by production  
from that well.

James D. Keisling  
James D. Keisling

Subscribed and sworn to before me on this 28th day of July

Karen Peters  
Notary Public

RECEIVED  
STATE CORPORATION COMMISSION  
CONS. DIV. WICHITA, KANSAS

My Commission expires My Commission expires June 19, 1990

07-31-86  
JUL 31 1986