

15-179-00195-00-00


STATE OF KANSAS  
STATE CORPORATION COMMISSION

Give All Information Completely  
Make Required Affidavit  
Mail or Deliver Report to:  
Conservation Division  
State Corporation Commission  
211 No. Broadway  
Wichita, Kansas

WELL PLUGGING RECORD

Sheridan County. Sec. 24 Twp. 6 Rge. 26 (~~25~~) (W)  
Location as "NE/CNW/SW" or footage from lines NE NE SW  
Lease Owner E. K. Carey Contractor  
Lease Name Vahling Well No. 1  
Office Address Box 620, McPherson, Kansas  
Character of Well (completed as Oil, Gas or Dry Hole) Dry hole  
Date well completed November 27, 1957  
Application for plugging filed November 26, 1957  
Application for plugging approved November 26, 1957  
Plugging commenced 3 A.M., November 27, 1957  
Plugging completed 4 A.M., November 27, 1957  
Reason for abandonment of well or producing formation Dry hole

NORTH

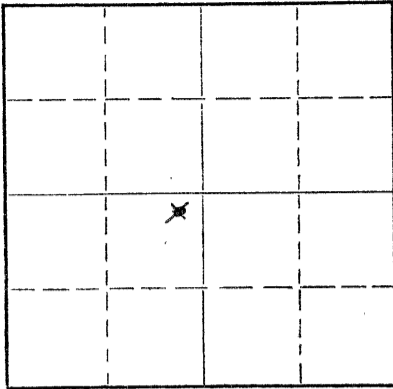

Locate well correctly on above Section Plat

If a producing well is abandoned, date of last production \_\_\_\_\_ 19\_\_\_\_  
Was permission obtained from the Conservation Division or its agents before plugging was commenced? Yes

Name of Conservation Agent who supervised plugging of this well Eldon Petty, Hays, Kansas  
Producing formation \_\_\_\_\_ Depth to top \_\_\_\_\_ Bottom \_\_\_\_\_ Total Depth of Well 3910 Feet  
Show depth and thickness of all water, oil and gas formations.

OIL, GAS OR WATER RECORDS

CASING RECORD

FORMATION	CONTENT	FROM	TO	SIZE	PUT IN	PULLED OUT
				8-5/8	265'	None

Describe in detail the manner in which the well was plugged, indicating where the mud fluid was placed and the method or methods used in introducing it into the hole. If cement or other plugs were used, state the character of same and depth placed, from 700'-635' feet to 40'-8' feet for each plug set. 240'-180'

Gunned pits, circulated heavy mud around from bottom up and layed down 1/2 of drill pipe and circulated heavy mud around again. Layed down all but 700' of drill pipe, made bridge with plug and mixed 20 sacks cement by Halliburton and pumped thru drill pipe. Layed down all but 240' of drill pipe, pushed plug to 240' with 1/2 sack hulls on top of plug and made bridge with rock to hold weight of 8 joints drill pipe. Mixed 20 sacks cement and pumped thru drill pipe. Layed down drill pipe and ran measuring line and filled hole with heavy mud to 40'. Put in plug with half sack hulls on top of plug. Mixed 10 sacks cement and filled to bottom of cellar floor. Through 4 A.M.

(If additional description is necessary, use BACK of this sheet)

Name of Plugging Contractor E. K. Carey Contractor  
Address Box 620, McPherson, Kansas

STATE OF Kansas, COUNTY OF McPherson, ss.  
Arland Bruce (employee of owner) or (owner or operator) of the above-described well, being first duly sworn on oath, says: That I have knowledge of the facts, statements, and matters herein contained and the log of the above-described well as filed and that the same are true and correct. So help me God.

(Signature) Arland Bruce Tool Pusher  
Box 620, McPherson, Kansas  
(Address)

SUBSCRIBED AND SWORN TO before me this 29th day of November, 1957

My commission expires November 13, 1968  
[Signature] Notary Public.

PLUGGING  
FILE SEC 24 T 6 R 24W  
BOOK PAGE 64 LINE 45

12-2-57