


Give All Information Completely
Make Required Affidavit
Mail or Deliver Report to:
Conservation Division
State Corporation Commission
800 Bittling Building
Wichita, Kansas

WELL PLUGGING RECORD

Sheridan County. Sec. 25 Twp. 6S Rge. 26 (W) (W)
Location as "NE/CNW/SW" or footage from lines NE/4 NE/4 NW/4
Lease Owner Heathman-Seeligson Drilling Co.
Lease Name Wente Well No. 1
Office Address 1015 East Second, Wichita, Kansas
Character of Well (completed as Oil, Gas or Dry Hole) Dry Hole
Date well completed 1-14- 19 55
Application for plugging filed 1-14- 19 55
Application for plugging approved 1-14- 19 55
Plugging commenced 1-14- 19 55
Plugging completed 1-14- 19 55
Reason for abandonment of well or producing formation Dry Hole

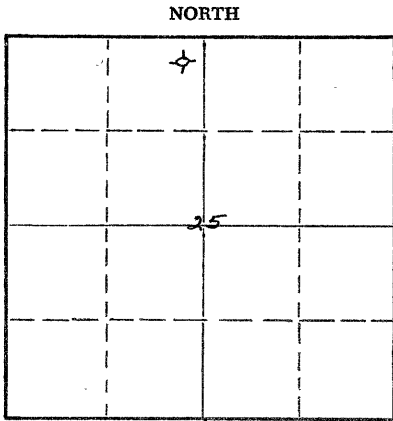

If a producing well is abandoned, date of last production --- 19 ---
Was permission obtained from the Conservation Division or its agents before plugging was commenced? yes

Name of Conservation Agent who supervised plugging of this well Eldon Petty, Hays, Kansas
Producing formation none Depth to top --- Bottom --- Total Depth of Well 3500 Feet
Show depth and thickness of all water, oil and gas formations. plus or minus

OIL, GAS OR WATER RECORDS

CASING RECORD

| FORMATION | CONTENT | FROM | TO | SIZE | PUT IN | PULLED OUT |
|-----------|---------|------|----|---------------------|--------|------------|
| | | | | 9 jts. 8-5/8" 8V | | |
| | | | | thd. csg. set at | | |
| | | | | 279.47' cemented w/ | | |
| | | | | 150 sacks cement & | | |
| | | | | 2 Gal. Chloride | | |

Describe in detail the manner in which the well was plugged, indicating where the mud fluid was placed and the method or methods used in introducing it into the hole. If cement or other plugs were used, state the character of same and depth placed, from _____ feet to _____ feet for each plug set.

Stirred pits. Filled hole with heavy mud. Set plug at 270' with 1/2 sacks hulls and 15 sacks cement. Set topplug at 40' with 10 sacks cement.

(If additional description is necessary, use BACK of this sheet)

Name of Plugging Contractor Heathman-Seeligson Drilling Co.
Address 1015 East Second, Wichita, Kansas

STATE OF Kansas, COUNTY OF Sedgwick, ss.
H. D. Shreve (employee of owner) or (~~owner or operator~~) of the above-described well, being first duly sworn on oath, says: That I have knowledge of the facts, statements, and matters herein contained and the log of the above-described well as filed and that the same are true and correct. So help me God.

(Signature) By: [Signature]
1015 East Second, Wichita, Kansas
(Address)

SUBSCRIBED AND SWORN TO before me this 19th day of January, 1955

My commission expires June 28, 1956

[Signature] Notary Public.

