

STATE OF KANSAS  
STATE CORPORATION COMMISSION


15-179-05308-00-00  
WELL PLUGGING RECORD

Give All Information Completely  
Make Required Affidavit  
Mail or Deliver Report to:  
Conservation Division  
State Corporation Commission  
800 Bittling Building  
Wichita, Kansas

OR  
FORMATION PLUGGING RECORD

Strike out upper line  
when reporting plug-  
ging off formations.

NORTH

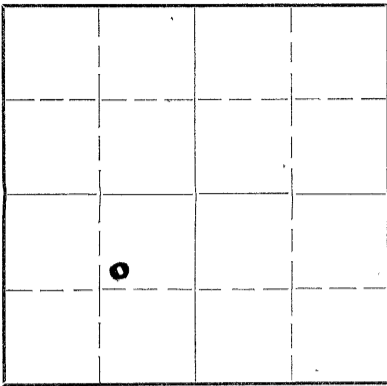

Locate well correctly on above  
Section Plat

Sheridan County, Sec. 24 Twp. 6S. Rge. 26W. (E) (W)  
Location as "NE $\frac{1}{4}$ NW $\frac{1}{4}$ SW $\frac{1}{4}$ " or footage from lines SW $\frac{1}{2}$  NE $\frac{1}{2}$  SW $\frac{1}{2}$   
Lease Owner Continental Oil Co.  
Lease Name Vahling Well No. 1  
Office Address Ponca City, Oklahoma  
Character of Well (completed as Oil, Gas or Dry Hole) Stratigraphic Test  
Date well completed July 6, 19 43  
Application for plugging filed July 6, 19 43  
Application for plugging approved July 6, 19 43  
Plugging commenced July 6, 19 43  
Plugging completed July 7, 19 43  
Reason for abandonment of well or producing formation

If a producing well is abandoned, date of last production 19  
Was permission obtained from the Conservation Division or its agents before plugging was com-  
menced? Yes

Name of Conservation Agent who supervised plugging of this well Burt Stafford  
Producing formation Depth to top Bottom Total Depth of Well 4200 Feet  
Show depth and thickness of all water, oil and gas formations.

OIL, GAS OR WATER RECORDS


CASING RECORD

Formation	Content	From	To	Size	Put In	Pulled Out
				8 5/8"	349 ft.	None

Describe in detail the manner in which the well was plugged, indicating where the mud fluid was placed and the method or methods used in introducing it into the hold. If cement or other plugs were used, state the character of same and depth placed, from feet to feet for each plug set.

The hole was filled with heavy mud and a plug set by circulating to 349 feet where a plug was set and cemented with 15 sacks of cement. The hole was then filled with mud to 25 feet where another plug was set and cemented to the top.

PLUGGING  
FILE SEC 24 6 26W  
BOOK PAGE 81 LINE 39

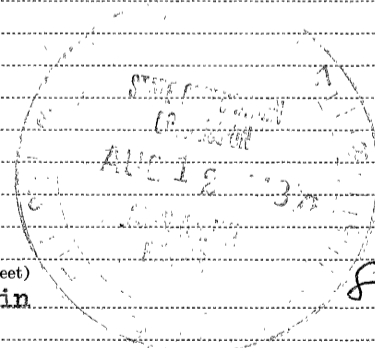

(If additional description is necessary, use BACK of this sheet)  
Correspondence regarding this well should be addressed to J. George Klein  
Address Box 471 Norton, Kansas

STATE OF Kansas, COUNTY OF Rooks Norton, ss.  
J. George Klein (employee of owner) or (owner or operator) of the above-described well,  
being first duly sworn on oath, says: That I have knowledge of the facts, statements, and matters herein contained and the log of the above-described well as filed and that the same are true and correct. So help me God.

(Signature) J. George Klein  
Norton, Kans.

SUBSCRIBED AND SWORN to before me this 11 day of August 19 43  
Notary Public.

My commission expires January 26, 1947