

15-065-30140-00-00

STATE OF KANSAS
STATE CORPORATION COMMISSION

Form CP-4

WELL PLUGGING RECORD

Give All Information Completely
Make Required Affidavit
Mail or Deliver Report to:
Conservation Division
State Corporation Commission
211 No. Broadway
Wichita, Kansas

GRAHAM County, Sec. 5 Twp. 6S Rge. 24 (X) (W)

Location as "NE/CNW%SW%" or footage from lines SE SE

Lease Owner PETROLEUM, INC.

Lease Name PETERSON Well No. 1

Office Address ROUTE #2, GREAT BEND, KANSAS

Character of Well (completed as Oil, Gas or Dry Hole) DRY HOLE

Date well completed DEC. 27 19 65

Application for plugging filed DEC. 27 19 65


Application for plugging approved DEC. 27 19 65

Plugging commenced DEC. 27 19 65

Plugging completed DEC. 27 19 65

Reason for abandonment of well or producing formation NO PRODUCIBLE ZONE

NORTH

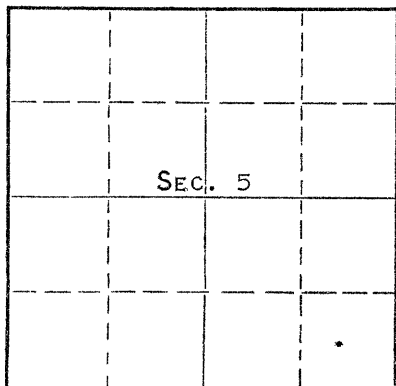

Locate well correctly on above
Section Plat

If a producing well is abandoned, date of last production NONE 19

Was permission obtained from the Conservation Division or its agents before plugging was commenced? YES

Name of Conservation Agent who supervised plugging of this well W. L. NICHOLS

Producing formation Depth to top Bottom Total Depth of Well 3635' Feet

Showing and thickness of all water, oil and gas formations.

OIL, GAS OR WATER RECORDS

CASING RECORD

FORMATION	CONTENT	FROM	TO	SIZE	PUT IN	PULLED OUT
				8-5/8"	216'	NONE

Describe in detail the manner in which the well was plugged, indicating where the mud fluid was placed and the method or methods used in introducing it into the hole. If cement or other plugs were used, state the character of same and depth placed, from feet to feet for each plug set.

MUDDED UP WITH HEAVY DRILLING MUD TO 540', FOLLOWED BY WOODEN PLUG, PLACED 20 SACKS CEMENT ON TOP OF PLUG. MUDDED UP WITH HEAVY MUD TO 200', FOLLOWED BY WOODEN PLUG, PLACED 25 SACKS CEMENT ON TOP OF PLUG. MUDDED UP WITH HEAVY MUD TO 40', FOLLOWED BY WOODEN PLUG, PLACED 1/2 SACK HULLS AND 10 SACKS CEMENT ON TOP OF PLUG TO BASE OF WELL CELLAR.

RECEIVED
STATE CORPORATION COMMISSION

JAN 6 1966

CONSERVATION DIVISION
Wichita, Kansas

(If additional description is necessary, use BACK of this sheet)

Name of Plugging Contractor GARVEY DRILLING COMPANY
Address R.R. #2, GREAT BEND, KANSAS

1-6-66

STATE OF KANSAS, COUNTY OF BARTON, ss.

MONTE CHADD (employee of owner) or (owner or operator) of the above-described well, being first duly sworn on oath, says: That I have knowledge of the facts, statements, and matters herein contained and the log of the above-described well as filed and that the same are true and correct. So help me God. MONTE CHADD, DIST. PROD. SUPT.

(Signature) *Monte Chadd*

R. R. #2, GREAT BEND, KANSAS
(Address)

SUBSCRIBED AND SWORN TO before me this 4 day of JANUARY, 19 66

My commission expires MAY 28, 1969

Richard N. Dumble
Notary Public.

15-065-30140-00-00

WELL LOG

COMPANY Petroleum, I nc.
FARM Peterson NO. 1


SEC. 5 T. 6S R. 24W
LOC. C SE SE

TOTAL DEPTH 3635'

COUNTY Graham

COMM. 12-17-65 COMP. 12-27-65

CONTRACTOR Garvey Drilling Company

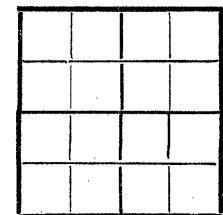

CASING 8 5/8" @ 216' w/180 sx

ELEVATION 2450' DF

PRODUCTION D & A

FIGURES INDICATE BOTTOM OF FORMATIONS

- 160' Clay and Sand
- 300' Shale
- 1400' Shale and Sand
- 1650' Shale and Sand Streaks
- 1670' Shale
- 1835' Sand
- 2067' Shale
- 2102' Anhydrite
- 2535' Shale
- 2825' Shale and Shells
- 2880' Shale
- 2945' Shale and Lime
- 3620' Lime
- 3635' RTD

RECEIVED
STATE CORPORATION COMMISSION
JAN 6 1966
1-6-66
CONSERVATION DIVISION
Wichita, Kansas

State of Kansas }
County of Barton } SS

I, Sam N. Stephens of Garvey Drilling Company

upon oath state the above and foregoing is a true and correct copy of the log of the Peterson No. 1 well.

Sam N. Stephens

Subscribed and sworn to before me this 4th day of January 19 66

My Commission Expires: November 5, 1969

Richard Doy
NOTARY PUBLIC