

15-179-05294-00-00


STATE OF KANSAS
STATE CORPORATION COMMISSION

Give All Information Completely
Make Required Affidavit
Mail or Deliver Report to:
Conservation Division
State Corporation Commission
800 Bitting Building
Wichita, Kansas

WELL PLUGGING RECORD

Sheridan, Kansas County. Sec. 2 Twp. 6S Rge. (E) 27 (W)

Location as "NE/CNW 1/4 SW 1/4" or footage from lines SW NW NE
Lease Owner D.N.M. Oil Company
Lease Name Boutz Well No. 1
Office Address Oberlin, Kansas
Character of Well (completed as Oil, Gas or Dry Hole) Dry Hole
Date well completed February 4 1949
Application for plugging filed February 4 1949
Application for plugging approved February 4 1949
Plugging commenced February 4 1949
Plugging completed February 4 1949
Reason for abandonment of well or producing formation Dry Hole

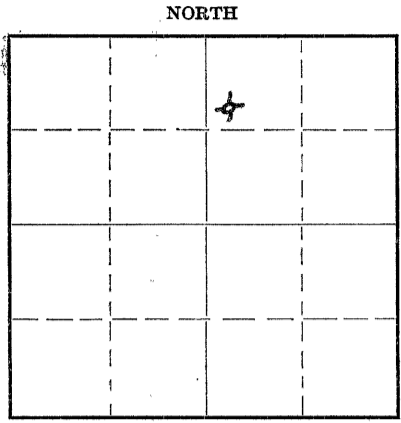

Locate well correctly on above Section Plat

If a producing well is abandoned, date of last production 19...
Was permission obtained from the Conservation Division or its agents before plugging was commenced? Yes

Name of Conservation Agent who supervised plugging of this well C. R. Petty
Producing formation Depth to top Bottom Total Depth of Well 3830 Feet
Show depth and thickness of all water, oil and gas formations.

OIL, GAS OR WATER RECORDS

CASING RECORD

Formation	Content	From	To	Size	Put In	Pulled Out
		0	282	8 5/8	282	None

Describe in detail the manner in which the well was plugged, indicating where the mud fluid was placed and the method or methods used in introducing it into the hole. If cement or other plugs were used, state the character of same and depth placed, from...feet to...feet for each plug set.

- 3830' - 277' - Heavy Rotary Mud
- 277' - 275' - Wooden Plug
- 275' - 237 1/2' - 15 sacks cement
- 237 1/2' - 32' - Heavy Rotary Mud
- 32' - 30' - Wooden Plug
- 30' - 6' - 10 sacks cement
- 6' - Surface - Cellar

RECEIVED
Conservation Div.
FEB 18 1949
STATE CORPORATION COMMISSION
KANSAS
2-18-49

(If additional description is necessary, use BACK of this sheet)
Correspondence regarding this well should be addressed to D.N.M. Oil Company
Address Oberlin, Kansas

STATE OF Kansas, COUNTY OF Barton, ss.
Glenn Peel Drilling Company, Inc. (employee of owner) or (owner/operator) of the above-described well,
being first duly sworn on oath, says: That I have knowledge of the facts, statements, and matters herein contained and the log of the above-described well as filed and that the same are true and correct. So help me God. GLENN PEEL DRILLING COMPANY, INC.

(Signature) BY: Glenn Peel
P.O. Box 359, Hoisington, Kansas (Address)

SUBSCRIBED AND SWORN to before me this 14th day of February 1949
Marian M. Herbert Notary Public.

My commission expires June 4, 1951

22-5133-s 9-48-10M

PLUGGING
FILE SEC 2 T 6 R 270
BOOK PAGE 88 LINE 15

15-179-05294-00-00

DRILLER'S LOG

Company: D.N.M. Oil Company

Sec. 2 Twp. 6S Rge. 27W
SW NW NE

Farm: Boutz Well No. 1

County: Sheridan
Kansas

Total Depth: 3830'

Comm.: 1-27-49 Comp.: 2-4-49
Contractor: Glenn Peel Drilling Company, Inc.
Casing: 8 5/8" 282' cem.

Elevation:

Production:

Figures below indicate bottom of formations

Surface Clay	0 -	33
Sand		60
Shale and Clay		280
Shale and Shells		1150
Sand		1205
Shale and Shells		1610
Shale and Shell Breaks		1835
Sandy Shale		1950
Shale and Shells		2150
Anhydrite		2190
Shale and Shells		2310
Shale and Lime		2350
Shale and Shell Breaks		2600
Shale and Shells		2980
Shale and Shell Breaks		3140
Shale and Shells		3235
Shale and Lime		3305
Shale and Lime Streaks		3500
Shale and Broken Lime		3745
Broken Lime		3830
Total Depth		3830

This is to certify that the above information, is to the best of our knowledge, true and correct.

GLENN PEEL DRILLING COMPANY, INC.

BY: *Glenn E. Peel*

SUBSCRIBED AND SWORN to before me this 14th day of February, 1949

My commission expires June 4, 1951

Marian M. Herber
Notary Public

RECORDED
INDEXED
SHERIDAN COUNTY
KANSAS
2-18-49

PLUGGING
FILE SEC 2 T 6 R 27W
BOOK PAGE 82 LINE 5