

15-179-05291-00-02


STATE OF KANSAS  
STATE CORPORATION COMMISSION

Form CP-4

WELL PLUGGING RECORD

Give All Information Completely  
Make Required Affidavit  
Mail or Deliver Report to:  
Conservation Division  
State Corporation Commission  
212 No. Market  
Wichita, Kansas

NORTH

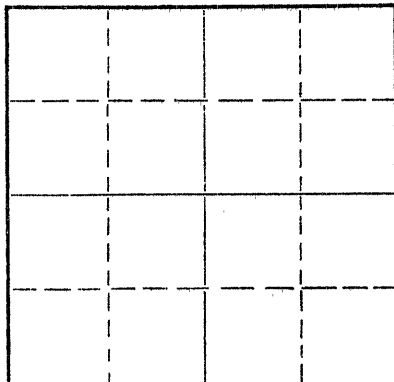

Locate well correctly on above  
Section Plat

Sheridan County, Sec. 2 Twp. 6 Rge. 27 (E) W (W)  
Location as "NE/CNWxSWx" or footage from lines 990' N & 990' E of Sect. corner.  
Lease Owner Knight Casing Pulling Company  
Lease Name B. H. Boutz (K. C. Unit #702) Well No. 2  
Office Address Chase, Kansas  
Character of Well (completed as Oil, Gas or Dry Hole)  
Date well completed 19  
Application for plugging filed 19  
Application for plugging approved 19  
Plugging commenced 4-22-66 19  
Plugging completed 4-25-66 19  
Reason for abandonment of well or producing formation Depleted.

If a producing well is abandoned, date of last production 19  
Was permission obtained from the Conservation Division or its agents before plugging was commenced? yes

Name of Conservation Agent who supervised plugging of this well Nichols  
Producing formation Depth to top Bottom Total Depth of Well 3793 Feet  
Show depth and thickness of all water, oil and gas formations.

OIL, GAS OR WATER RECORDS

CASING RECORD

FORMATION	CONTENT	FROM	TO	SIZE	PUT IN	PULLED OUT
				10"	240'	None
				6"	3792'	1072'

Describe in detail the manner in which the well was plugged, indicating where the mud fluid was placed and the method or methods used in introducing it into the hole. If cement or other plugs were used, state the character of same and depth placed, from feet to feet for each plug set.

Checked hole to 3790', pushed plug to 3650' and dumped 5 sacks of cement with dump bailer. Pulled 6" casing to 600' and circulated with 20 sacks of gel mud. Pulled casing to 540' and pumped in 20 sacks of cement. Pulled casing to 180' and pumped in 20 sacks of cement. Pulled balance of 6" casing, set rock bridge @ 30' and capped well with 10 sacks of cement.

RECEIVED  
STATE CORPORATION COMMISSION

APR 29 1966

PLUGGING COMPLETE.

CONSERVATION DIVISION  
WICHITA, KANSAS

Name of Plugging Contractor KNIGHT CASING PULLING COMPANY  
Address CHASE, KANSAS  
(If additional description is necessary, use BACK of this sheet)

STATE OF KANSAS, COUNTY OF RICE, ss.  
Noel J. Knight (employee of owner) or (owner or operator) of the above-described well, being first duly sworn on oath, says: That I have knowledge of the facts, statements, and matters herein contained and the log of the above-described well as filed and that the same are true and correct. So help me God.

(Signature) Noel J. Knight  
Chase, Kansas

SUBSCRIBED AND SWORN TO before me this 28th day of April, 1966

My commission expires May 20, 1968 Milton J. Volin Notary Public.