

15-179-05275-00 @

STATE OF KANSAS
STATE CORPORATION COMMISSION


Form CP-4

WELL PLUGGING RECORD

Give All Information Completely
Make Required Affidavit
Mail or Deliver Report to:
Conservation Division
State Corporation Commission
P. O. Box 17027
Wichita, Kansas 67217
NORTH

Sheridan County, Sec. 2 Twp. 6 Rge. (E) 27 (W)

Location as "NE/CNW/SW" or footage from lines SW NW SW
Lease Owner Continental Oil Company
Lease Name Adell LKC Unit Well No. 405
Office Address Box 267, Great Bend, Kansas 67530
Character of Well (completed as Oil, Gas or Dry Hole) oil
Date well completed 19
Application for plugging filed 19
Application for plugging approved 19
Plugging commenced October 18 19 76
Plugging completed November 3 19 76
Reason for abandonment of well or producing formation depleted

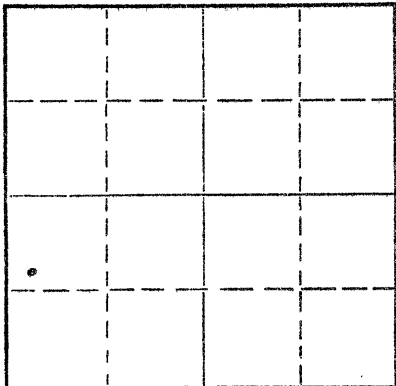

Locate well correctly on above Section Plat

If a producing well is abandoned, date of last production 19
Was permission obtained from the Conservation Division or its agents before plugging was commenced? yes

Name of Conservation Agent who supervised plugging of this well Gilbert Balthazor
Producing formation _____ Depth to top _____ Bottom _____ Total Depth of Well 3840 Feet
Show depth and thickness of all water, oil and gas formations.

OIL, GAS OR WATER RECORDS

CASING RECORD

FORMATION	CONTENT	FROM	TO	SIZE	PUT IN	PULLED OUT
			254'	10 3/4"	254'	none
			3839'	6"	3839'	1034.91

Describe in detail the manner in which the well was plugged, indicating where the mud fluid was placed and the method or methods used in introducing it into the hole. If cement or other plugs were used, state the character of same and depth placed, from _____ feet to _____ feet for each plug set.

Sanded back to 3500' and dumped 5 sacks of cement.

Sun Cementing Company plugged well pumping in 4 sacks of bulls, 16 sacks of gel and 150 sacks of cement.

15-26

(If additional description is necessary, use BACK of this sheet)
Name of Plugging Contractor PIPE PULLERS, INC.
Address Box 128, Ellinwood, Kansas 67526

STATE OF KANSAS, COUNTY OF BARTON, SS.
Evelyn Roth (employee of owner) or (owner or operator) of the above-described well, being first duly sworn on oath, says: That I have knowledge of the facts, statements, and matters herein contained and the log of the above-described well as filed and that the same are true and correct. So help me God.

(Signature) Evelyn Roth
Ellinwood, Kansas (Address)

SUBSCRIBED AND SWORN to before me this 9th day of November, 19 76

My commission expires _____

JENNY KASSELMAN
NOTARY PUBLIC
BARTON COUNTY, KANSAS
MY COMM. EXP. JULY 16, 1978

Jenny Kasselmann
Notary Public.

WELL LOG

C SW NW SW

CONTINENTAL OIL COMPANY

W. C. Carlton #5

Adell Lansing KC Dist No 405

Described as your W. C. Carlton Well No. 5
located in Section 2, Township 6 South,
Range 27 West, Sheridan County, Kansas.

<u>FORMATION</u>	<u>FROM</u>	<u>TO</u>
Surface	0	41
Sand	41	280
Set:		
251' of 10 3/4" casing		
Sand & Shale	280	556
Shale, Shells, & Sand	556	1161
Shale, shells, sand	1161	1385
Shale, sand, shells	1385	1585
Shale & Shells	1585	1890
Shale & Shells	1890	2150
Shale	2150	2153
Anhydrite	2153	2188
Shale & Lime	2188	2216
Lime & Shale	2391	2726
Lime	2726	2771
Lime & Shale	2771	2951
Lime & Shale	2951	3109
Lime	3109	3156
Lime & Shale	3156	3524
Lime	3524	3589
Lime & Shale	3589	3643
Lime	3643	3840
Total depth:	3840'	

Copy to Neal Rept 11-20-47

