


15-179-05295-00-00

WELL PLUGGING RECORD

STATE OF KANSAS STATE CORPORATION COMMISSION Give All Information Completely Make Required Affidavit Mail or Deliver Report to: Conservation Division State Corporation Commission 800 Bitting Building Wichita, Kansas

OR FORMATION PLUGGING RECORD Strike out upper line when reporting plugging of formations.

Sheridan County. Sec. 1 Twp. 6 Rge. (E) 27 (W) Location as "NE 1/4 NW 1/4 SW 1/4" or footage from lines SW 1/4 NW 1/4 SW 1/4 Lease Owner Musgrove Petroleum Corporation Lease Name Cramer Well No. 1 Office Address 407 K.F.H. Building, Wichita, Kansas Character of Well (completed as Oil, Gas or Dry Hole) Dry Hole Date well completed 19 Application for plugging filed 9-15 1949 Application for plugging approved 9-15 1949 Plugging commenced 9-15 1949 Plugging completed 9-18 1949 Reason for abandonment of well or producing formation Dry

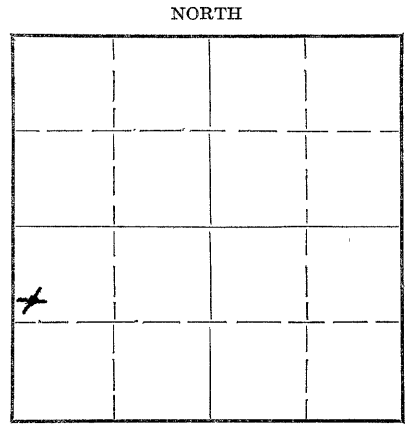

Locate well correctly on above Section Plat

If a producing well is abandoned, date of last production 19 Was permission obtained from the Conservation Division or its agents before plugging was commenced? Elden Petty

Name of Conservation Agent who supervised plugging of this well Producing formation Depth to top Bottom Total Depth of Well 3793 Feet Show depth and thickness of all water, oil and gas formations.

OIL, GAS OR WATER RECORDS

CASING RECORD

Table with 7 columns: Formation, Content, From, To, Size, Put In, Pulled Out. Row 1: 8-5/8", 242', Cemented. Row 2: 5-1/2", 3767', 1804'.

Describe in detail the manner in which the well was plugged, indicating where the mud fluid was placed and the method or methods used in introducing it into the hole. If cement or other plugs were used, state the character of same and depth placed, from feet to feet for each plug set.

Dumped 5 sacks of cement at 3568', on top of Lane-Wells plug. Shot off 1804' of 5 1/2" pipe. Pulled 1804' of 5 1/2" pipe. Mudded hole to 242'. Set 10' of rock bridge at 242'. Dumped 15 sacks of cement on top of rock bridge at 232'. Mudded hole to 30'. Dumped 10 sacks of cement in top 30' of hole.

RECORDED

SEP 28 1949

9-28-49

(If additional description is necessary, use BACK of this sheet)

Correspondence regarding this well should be addressed to Musgrove Petroleum Corporation Address 407 K.F.H. Building Wichita, Kansas

STATE OF KANSAS, COUNTY OF SEDGWICK, ss. Gordon L. Koelling (employee of owner) or (owner or operator) of the above-described well,

being first duly sworn on oath, says: That I have knowledge of the facts, statements, and matters herein contained and the log of the above-described well as filed and that the same are true and correct. So help me God.

(Signature) Gordon L. Koelling 407 K.F.H. Bldg., Wichita, Kansas (Address)

SUBSCRIBED AND SWORN to before me this 26th day of September, 1949

Madeline J. Jirels Notary Public.

My commission expires December 5, 1951

PLUGGING FILE SEC 1 T 6 R 270 BOOK PAGE 115 LINE 6

CONTRACTOR'S WELL LOG

Operator Musgrove Petroleum Corporation Farm Name Cramer No. I
 Location SW $\frac{1}{4}$ NW $\frac{1}{4}$ SW $\frac{1}{4}$ Sec. 1-6-27W.
 Pool Name Adell County Sheridan State Kansas
 Commencement Date 8-12-49 Completion Date 8-25-49

LOG OF WELL

Elevation 2554' DF
 All measurements from the top of rotary bushing.

FROM	DEPTH TO	FORMATION	DEVIATION FROM VERTICAL	REMARKS:
0	125	Shale-Shells		
125	240	Sand-Shale		
240	345	Shale-Sand		
345	610	Shale		
610	650	Sandy Lime		
650	850	Black Shale		
850	1100	Shale-Shells-Sand		
1100	1480	Shale-Shells		
1480	1639	Shale-Shells		
1639	1895	Red Bed-Shale		
1895	2115	Shale-Red Bed		
2115	2150	Anhydrite		
2150	2175	Shale-Red Bed		
2175	2415	Shale-Lime	2200' - 0°	
2415	2570	Shale-Lime		
2570	2715	Shale-Shells	2500' - 0°	
2715	2835	Shale-Lime		
2835	2890	Lime-Shale		
2890	2965	Lime-Shale		
2965	3035	Lime-Shale		
3035	3085	Lime-Shale	3000' - 0°	
3085	3135	Lime-Shale		
3135	3215	Lime-Shale		
3215	3275	Lime-Shale		
3275	3335	Lime-Shale		
3335	3384	Lime-Shale		
3385	3445	Lime-Shale		
3445	3485	Lime-Shale		
3485	3775	Lime		

RECEIVED

Conservation Dept.
 SEP 20 1949
 STATE CORPORATION
 COMMISSION
 KANSAS

9-20-49

CASING LEFT IN HOLE AFTER COMPLETION

241.92' (8 jts.) 8-5/8" OD Casing.
 3775.01' (121 jts.) 5-1/2" OD Casing.
 STATE OF KANSAS, COUNTY OF SEDGWICK) ss.

The undersigned certifies that to the best of his knowledge and belief the above facts are true and correct.

C-G DRILLING COMPANY, Inc.
 By [Signature], President

Subscribed and sworn to before me this 29th day of August, 1949.

My commission expires:
 June 25, 1951

PLUGGING
 FILE SEC 1-6-27W
 BOOK PAGE 115 LIME 6

[Signature]
 Notary Public