

FOR KCC USE:

* 2ND CORRECTION *

FORM C-1 7/91

EFFECTIVE DATE:

State of Kansas

FORM MUST BE TYPED

DISTRICT #

NOTICE OF INTENTION TO DRILL

FORM MUST BE SIGNED

SGA? Yes No

Must be approved by the K.C.C. five (5) days prior to commencing well

ALL BLANKS MUST BE FILLED

* Expected Spud Date October 1 1993 month day year

* Spot 90 ft. S of C N2 SE SW Sec 17 Twp 6 S Rg 26 East West

OPERATOR: License # 5663 Name: Hess Oil Company Address: P.O. Box 1009 City/State/Zip: McPherson, KS 67460 Contact Person: Bryan Hess Phone: 316-241-4640

* 900 feet from South / North line of Section * 1980 feet from East / West line of Section IS SECTION X REGULAR IRREGULAR?

CONTRACTOR: License #: 4958 Name: Mallard JV, Inc.

(NOTE: Locate well on the Section Plat on Reverse Side) County: Sheridan Lease Name: Ross Shipley Well #: 1 Field Name:

Well Drilled For: Well Class: Type Equipment: X Oil Enh Rec Infield X Mud Rotary Gas Storage Pool Ext Air Rotary OWWO Disposal X Wildcat Cable Seismic: # of Holes Other

Is this a Prorated/Spaced Field? yes X no Target Formation(s): Lansing Nearest lease or unit boundary: 650' Ground Surface Elevation: 2656' est feet MSL Water well within one-quarter mile: yes X no Public water supply well within one mile: yes X no Depth to bottom of fresh water: 260' Depth to bottom of usable water: 1500' Surface Pipe by Alternate: 1 X 2 Length of Surface Pipe Planned to be set: 340' Length of Conductor pipe required: None Projected Total Depth: 3940' Formation at Total Depth: Lansing Water Source for Drilling Operations: well X farm pond other

If OWWO: old well information as follows: Operator: Well Name: Comp. Date: Old Total Depth

10-1-93 COR II

Directional, Deviated or Horizontal wellbore? yes no

DWR Permit #: Will Cores Be Taken? yes X no If yes, proposed zone:

If yes, true vertical depth:

Bottom Hole Location:

X Was Cor II n/2 s/2 sw 835 ft. f.s.l. 1415 f.w.l. AFFIDAVIT * X Is n/2 se sw 900 f.s.l. 1980 f.e.l. 750' n.l.b. 660 n.l.b.

The undersigned hereby affirms that the drilling, completion and eventual plugging of this well will comply with K.S.A. 55-101, et. seq.

It is agreed that the following minimum requirements will be met:

- 1. Notify the appropriate district office prior to spudding of well;
2. A copy of the approved notice of intent to drill shall be posted on each drilling rig;
3. The minimum amount of surface pipe as specified below shall be set by circulating cement to the top; in all cases surface pipe shall be set through all unconsolidated materials plus a minimum of 20 feet into the underlying formation;
4. If the well is dry hole, an agreement between the operator and the district office on plug length and placement is necessary prior to plugging;
5. The appropriate district office will be notified before well is either plugged or production casing is cemented in;
6. IF AN ALTERNATE II COMPLETION, PRODUCTION PIPE SHALL BE CEMENTED FROM BELOW ANY USABLE WATER TO SURFACE WITHIN 120 DAYS OF SPUD DATE. IN ALL CASES, NOTIFY DISTRICT OFFICE PRIOR TO ANY CEMENTING.

I hereby certify that the statements made herein are true and to the best of my knowledge and belief.

Date: 9-27-93 Signature of Operator or Agent: Dan Richer Title: Controller

FOR KCC USE: API # 15- 179-21,065 - 00-00 Conductor pipe required NONE feet Minimum surface pipe required 340 feet per Alt. X (2) Approved by: CB orig. 9/8/93 XCOR II 9/17/93 * COR II 10/1/93 This authorization expires: ORIG. EXP. 3/8/94 (This authorization void if drilling not started within 6 months of effective date.) Spud date: Agent:

REMEMBER TO:

- File Drill Pit Application (form GDP-1) with Intent to Drill;
- File Completion Form ACO-1 within 120 days of spud date;
- File acreage attribution plat according to field proration orders;
- Notify appropriate district office 48 hours prior to workover or re-entry;
- Submit plugging report (CP-4) after plugging is completed;
- Obtain written approval before disposing or injecting salt water.

Mail to: Conservation Division, 200 Colorado Derby Building, 202 W. First St., Wichita, Kansas 67202-1286.

RECEIVED STATE CORPORATION COMMISSION

SEP 28 1993 9-28-93 CONSERVATION DIVISION Wichita, Kansas

17 6 26

IN ALL CASES PLOT THE INTENDED WELL ON THE PLAT BELOW

PLAT OF ACREAGE ATTRIBUTABLE TO A WELL IN A PRORATED OR SPACED FIELD



If the intended well is in a prorated or spaced field, please fully complete this side of the form. If the intended well is in a prorated or spaced field complete the plat below showing that the well will be properly located in relationship to other wells producing from the common source of supply. Please show all the wells within 1 mile of the boundaries of the proposed acreage attribution unit for gas wells and within 1/2 mile of the boundaries of the proposed acreage attribution unit for oil wells.

API NO. 15- _____
 OPERATOR Hess Oil Company LOCATION OF WELL: COUNTY Sheridan
 LEASE Ross Shipley * 900 feet from south/north line of section
 WELL NUMBER 1 * 1980 feet from east/west line of section
 FIELD _____ SECTION 17 TWP 6 RG 26W

NUMBER OF ACRES ATTRIBUTABLE TO WELL _____ IS SECTION _____ REGULAR or _____ IRREGULAR
 QTR/QTR/QTR OF ACREAGE _____ - _____ - _____ IF SECTION IS IRREGULAR, LOCATE WELL FROM NEAREST CORNER BOUNDARY.

Section corner used: _____ NE _____ NW _____ SE _____ SW
PLAT

(Show location of the well and shade attributable acreage for prorated or spaced wells.)
 (Show footage to the nearest lease or unit boundary line.)

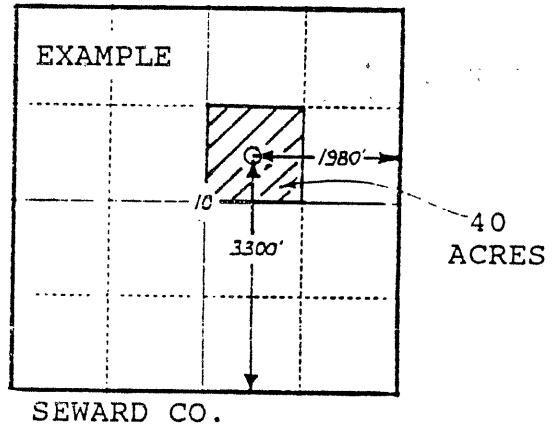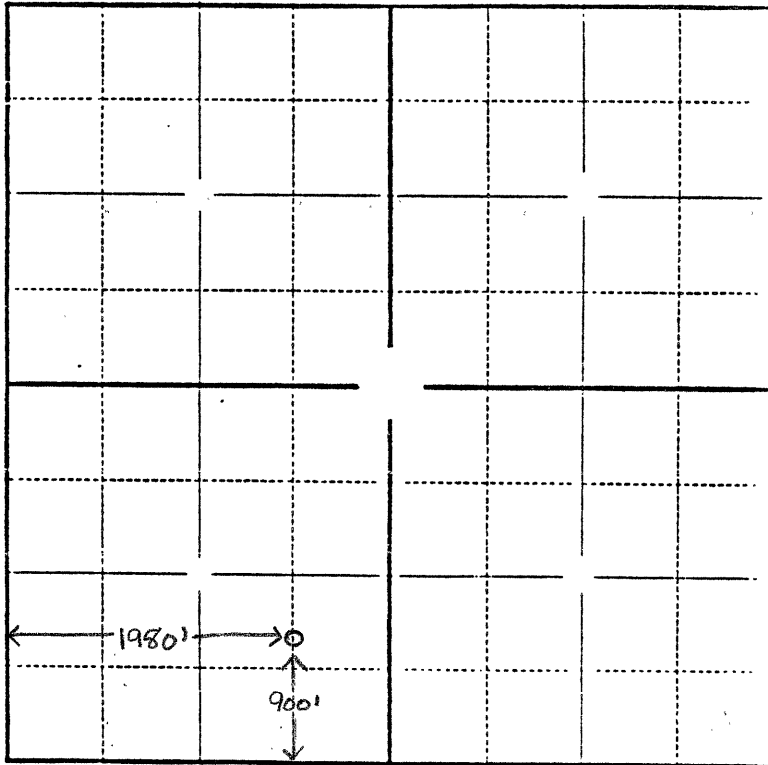

In plotting the proposed location of the well, you must show:

- 1) The manner in which you are using the depicted plat by identifying section lines, i.e. 1 section, 1 section with 8 surrounding sections, 4 sections, etc.;
- 2) the distance of the proposed drilling location from the section's south/north and east/west lines; and
- 3) the distance to the nearest lease or unit boundary line.