

CARD MUST BE TYPED

State of Kansas
NOTICE OF INTENTION TO DRILL
(see rules on reverse side)

CARD MUST BE SIGNED

Starting Date: ..December 15, 1984.....
month day year

API Number 15- 179-20,785-00-00

OPERATOR: License #5342.....
NameBeacon Exploration Company.....
Address410 17th St., Suite 2300.....
City/State/Zip ..Denver, Colorado...80202.....
Contact Person ..David Kranz.....
Phone(303) 825-1966.....

.SW. SW. NE ... Sec 26. Twp . 6 . S, Rge . 26 East
(location) West

.....2970..... Ft North from Southeast Corner of Section
.....2310..... Ft West from Southeast Corner of Section
(Note: Locate well on Section Plat on reverse side)

CONTRACTOR: License #6033.....
NameMurfin Drilling Company.....
City/State ..Wichita, Kansas.....

Nearest lease or unit boundary line2310... feet.
CountySheridan.....
Lease NameSlipkey..... Well# ..1-26...

Domestic well within 330 feet : yes no
Municipal well within one mile : yes no

Well Drilled For: Well Class: Type Equipment:
 Oil Swd Infield Mud Rotary
 Gas Inj Pool Ext. Air Rotary
 OWWO Expl Wildcat Cable

Depth to Bottom of fresh water250..... feet
Lowest usable water formationDakota.....
Depth to Bottom of usable water1400..... feet
Surface pipe by Alternate : 1 2
Surface pipe to be set300..... feet
Conductor pipe if any requiredN/A..... feet
Ground surface elevation2650..... feet MSL
This Authorization Expires6-5-85.....
Approved By12-5-84..... *RC*

If OWWO: old well info as follows:

Operator
Well Name
Comp Date Old Total Depth
Projected Total Depth4050..... feet
Projected Formation at TDLansing.....
Expected Producing FormationsLansing.....

I certify that we will comply with K.S.A. 55-101, et seq., plus eventually plugging hole to K.C.C. specifications.

Date ..12/3/84..... Signature of Operator or Agent

David Kranz


Title ..Drilg/Prod. Engineer.....

MHC/NOHE 12/5/84

**Must be filed with the K.C.C. five (5) days prior to commencing well
This card void if drilling not started within six (6) months of date received by K.C.C.**

Important procedures to follow :

**A Regular Section of Land
1 Mile = 5,280 Ft.**

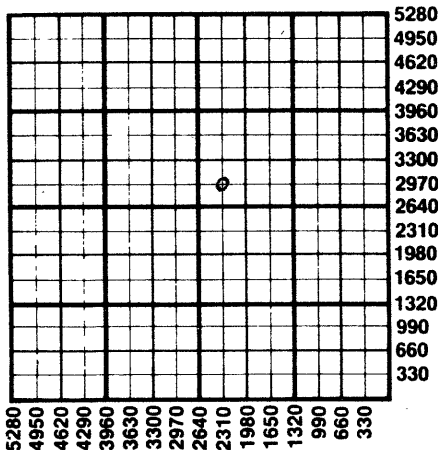

1. Notify District office before setting surface casing.
2. Set surface casing by circulating cement to the top.
3. File completion forms ACO-1 with K.C.C. within 90 days of well completion, following instructions on ACO-1, side 1, and including copies of wireline logs.
4. Notify District office 48 hours prior to old well workover or re-entry.
5. Prior to plugging, prepare a plugging plan, then obtain agreement from the appropriate district office for an approved plugging plan.
6. Submit plugging report (CP-4) to K.C.C. after plugging is completed.
7. Obtain an approved injection docket number before disposing of salt water.
8. Notify K.C.C. within 10 days when injection commences or terminates.
9. If an alternate 2 completion, cement in the production pipe from below any usable water to surface within 120 days of spud date.

RECEIVED

STATE CORPORATION COMMISSION OF KANSAS
Conservation Division

DEC 05 1984 200 Colorado Derby Building
Wichita, Kansas 67202

(316) 263-3238

CONSERVATION DIVISION
Wichita, Kansas