

CARD MUST BE TYPED

State of Kansas  
**NOTICE OF INTENTION TO DRILL**  
(see rules on reverse side)

CARD MUST BE SIGNED

Starting Date: December 15, 1984  
month day year

API Number 15- 179-20,784-00-00

OPERATOR: License # 5342  
Name Beacon Exploration Company  
Address 410.17th.St., Suite. 2300  
City/State/Zip Denver, Colorado 80202  
Contact Person David Kranz  
Phone (303).825-1966

SW.NE.SE. Sec 26. Twp 6. S, Rge 26.  East  
(location)  West

1650 Ft North from Southeast Corner of Section  
990 Ft West from Southeast Corner of Section  
(Note: Locate well on Section Plat on reverse side)

CONTRACTOR: License # 6033  
Name Murfin Drilling Company  
City/State Wichita, Kansas

Nearest lease or unit boundary line 990 feet.  
County Sheridan  
Lease Name Slipkey Well# 2-26

Domestic well within 330 feet:  yes  no  
Municipal well within one mile:  yes  no

Well Drilled For: Well Class: Type Equipment:  
 Oil  Swd  Infield  Mud Rotary  
 Gas  Inj  Pool Ext.  Air Rotary  
 OWWO  Expl  Wildcat  Cable

Depth to Bottom of fresh water 250 feet  
Lowest usable water formation Dakota  
Depth to Bottom of usable water 1400 feet  
Surface pipe by Alternate: 1  2   
Surface pipe to be set 300 feet  
Conductor pipe if any required N/A feet  
Ground surface elevation 2650 feet MSL  
This Authorization Expires 6-5-85  
Approved By 12-5-84 R

If OWWO: old well info as follows:

Operator  
Well Name  
Comp Date Old Total Depth  
Projected Total Depth 4050 feet  
Projected Formation at TD Lansing  
Expected Producing Formations Lansing

I certify that we will comply with K.S.A. 55-101, et seq., plus eventually plugging hole to K.C.C. specifications.

Date 12/3/84 Signature of Operator or Agent

*David Kranz*


Title Drlg/Prod Engineer

*AMHC/NOTE 12/5/84*

**Must be filed with the K.C.C. five (5) days prior to commencing well  
This card void if drilling not started within six (6) months of date received by K.C.C.**

**Important procedures to follow :**

**A Regular Section of Land  
1 Mile = 5,280 Ft.**

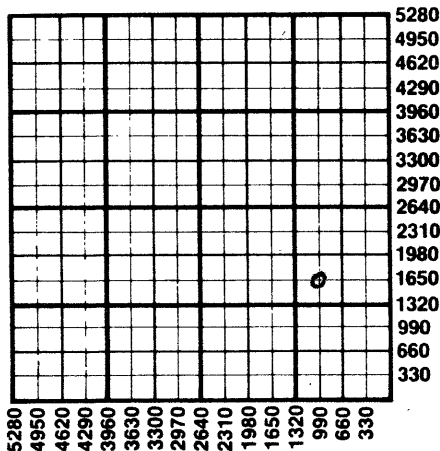

1. Notify District office before setting surface casing.
2. Set surface casing by circulating cement to the top.
3. File completion forms ACO-1 with K.C.C. within 90 days of well completion, following instructions on ACO-1, side 1, and including copies of wireline logs.
4. Notify District office 48 hours prior to old well workover or re-entry.
5. Prior to plugging, prepare a plugging plan, then obtain agreement from the appropriate district office for an approved plugging plan.
6. Submit plugging report (CP-4) to K.C.C. after plugging is completed.
7. Obtain an approved injection docket number before disposing of salt water.
8. Notify K.C.C. within 10 days when injection commences or terminates.
9. If an alternate 2 completion, cement in the production pipe from below any usable water to surface within 120 days of spud date.

**State Corporation Commission of Kansas**

**Conservation Division  
200 Colorado Derby Building  
Wichita, Kansas 67202  
(316) 263-3238**

**RECEIVED  
STATE CORPORATION COMMISSION**

**DEC 05 1984  
12-5-84  
CONSERVATION DIVISION  
Wichita, Kansas**