

CARD MUST BE TYPED

State of Kansas
NOTICE OF INTENTION TO DRILL
(see rules on reverse side)

CARD MUST BE SIGNED

Starting Date: December 8, 1984
month day year

API Number 15- 179-20, 78300-00

OPERATOR: License # 5342

NW NE SW Sec 26 6 S, Rge 26
(location) East West

Name Beacon Exploration Company

Address 410 17th St., Suite 2300

City/State/Zip Denver, Colorado 80202

Contact Person David Kranz

Phone (303) 825-1966

2310 Ft North from Southeast Corner of Section

3630 Ft West from Southeast Corner of Section

(Note: Locate well on Section Plat on reverse side)

CONTRACTOR: License # 6033

Nearest lease or unit boundary line 1650 feet.

County Sheridan

Name Murfin Drilling Co.

Lease Name Brandt Farms Well# 2-26

City/State Wichita, Kansas

Domestic well within 330 feet: yes no

Municipal well within one mile: yes no

Well Drilled For: Well Class: Type Equipment:
 Oil Swd Infield Mud Rotary
 Gas Inj Pool Ext. Air Rotary
 OWWO Expl Wildcat Cable

Depth to Bottom of fresh water 250 feet

Lowest usable water formation Dakota

Depth to Bottom of usable water 1400-1450 feet

Surface pipe by Alternate: 1 2

Surface pipe to be set 300 feet

Conductor pipe if any required N/A feet

Ground surface elevation 2635 feet MSL

This Authorization Expires 5-30-84

Approved By David Kranz

If OWWO: old well info as follows:

Operator

Well Name

Comp Date Old Total Depth

Projected Total Depth 4050 feet

Projected Formation at TD Lansing

Expected Producing Formations Lansing

I certify that we will comply with K.S.A. 55-101, et seq., plus eventually plugging hole to K.C.C. specifications.

Date 11/28/84 Signature of Operator or Agent

David Kranz

Title Drilling/Production Engineer


Form C-1 4/84

MHC/UCHE 11/30/84

**Must be filed with the K.C.C. five (5) days prior to commencing well
This card void if drilling not started within six (6) months of date received by K.C.C.**

Important procedures to follow :

**A Regular Section of Land
1 Mile = 5,280 Ft.**

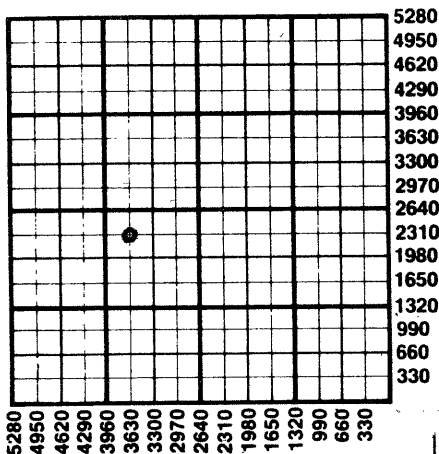

1. Notify District office before setting surface casing.
2. Set surface casing by circulating cement to the top.
3. File completion forms ACO-1 with K.C.C. within 90 days of well completion, following instructions on ACO-1, side 1, and including copies of wireline logs.
4. Notify District office 48 hours prior to old well workover or re-entry.
5. Prior to plugging, prepare a plugging plan, then obtain agreement from the appropriate district office for an approved plugging plan.
6. Submit plugging report (CP-4) to K.C.C. after plugging is completed.
7. Obtain an approved injection docket number before disposing of salt water.
8. Notify K.C.C. within 10 days when injection commences or terminates.
9. If an alternate 2 completion, cement in the production pipe from below any usable water to surface within 120 days of spud date.

11-30-84
NOV 30 1984

**State Corporation Commission of Kansas
Conservation Division
200 Colorado Derby Building
Wichita, Kansas 67202
(316) 263-3238**