

CARD MUST BE TYPED

CORRECTED

NOTICE OF INTENTION TO DRILL
(see rules on reverse side)

State of Kansas

CORRECTED
CARD MUST BE SIGNED

10-10-84

Starting Date: 10 15 84
month day year

API Number 15- 179-20,767-0000

OPERATOR: License # 5342
Name: Beacon Exploration Company
Address: 410 17th St., St., 2300
City/State/Zip: Denver, CO 80202
Contact Person: David Kranz
Phone: 303-825-1966

* NE SW NW Sec 26 Twp 6 S, Rge 26
(location)

* 3630 Ft North from Southeast Corner of Section
4290 Ft West from Southeast Corner of Section
(Note: Locate well on Section Plat on reverse side)

CONTRACTOR: License # 6033
Name: Murfin Drilling Company
City/State: Wichita, KS 67202

Nearest lease or unit boundary line 990 feet.
County: Sheridan
Lease Name: Teel Well# 1-26

Domestic well within 330 feet: yes no
Municipal well within one mile: yes no

Well Drilled For: Well Class: Type Equipment:
 Oil Swd Infield Mud Rotary
 Gas Inj Pool Ext. Air Rotary
 OWWO Expl Wildcat Cable

Depth to Bottom of fresh water 100 feet
Lowest usable water formation Dakota
Depth to Bottom of usable water 1200 / 1500 feet

If OWWO: old well info as follows:

Operator
Well Name
Comp Date Old Total Depth
Projected Total Depth 4050 feet
Projected Formation at TD Lans
Expected Producing Formations Lans

Surface pipe by Alternate: 1 2
Surface pipe to be set 250 feet
Conductor pipe if any required N/A feet
Ground surface elevation --- feet MSL
This Authorization Expires 4-1-85
Approved By 10-1-84

I certify that we will comply with K.S.A. 55-101, et seq., plus eventually plugging hole to K.C.C. specifications. *Kans NWSE-WW 3630 FSL*


Date 10-10-84 Signature of Operator or Agent

James R. Daniels
James R. Daniels, Agent for Operator Title General Manager

**Must be filed with the K.C.C. five (5) days prior to commencing well
This card void if drilling not started within six (6) months of date received by K.C.C.**

Important procedures to follow :

**A Regular Section of Land
1 Mile = 5,280 Ft.**

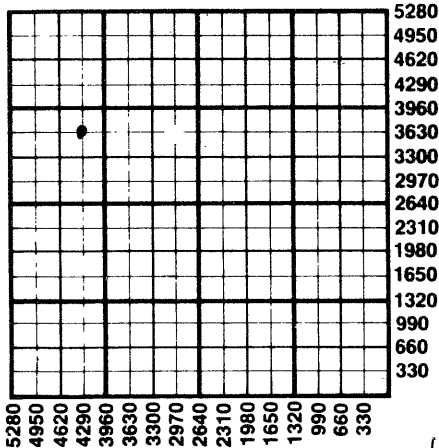

OK
/

10-10-84

1. Notify District office before setting surface casing.
2. Set surface casing by circulating cement to the top.
3. File completion forms ACO-1 with K.C.C. within 90 days of well completion, following instructions on ACO-1, side 1, and including copies of wireline logs.
4. Notify District office 48 hours prior to old well workover or re-entry.
5. Prior to plugging, prepare a plugging plan, then obtain agreement from the appropriate district office for an approved plugging plan.
6. Submit plugging report (CP-4) to K.C.C. after plugging is completed.
7. Obtain an approved injection docket number before disposing of salt water.
8. Notify K.C.C. within 10 days when injection commences or terminates.
9. If an alternate 2 completion, cement in the production pipe from below any usable water to surface within 120 days of spud date.

**State Corporation Commission of Kansas
Conservation Division
200 Colorado Derby Building
Wichita, Kansas 67202
(316) 263-3238**