

Exp. 2-6-85

CARD MUST BE TYPED

State of Kansas
NOTICE OF INTENTION TO DRILL
(see rules on reverse side)

CORRECTION
CARD MUST BE SIGNED

Starting Date: August 15 1874
month day year

API Number 15- 179-20,761-00-00
8984

OPERATOR: License # 5342
Name Beacon Exploration
Address 410 17th Street, Suite 2300
City/State/Zip Denver, CO 80202
Contact Person David Kranz
Phone (303) 825-1966

* NW NW SW Sec . 26 Twp . 6 S, Rge . 26
(location) East West
* 2190 Ft North from Southeast Corner of Section
* 4950 Ft West from Southeast Corner of Section
(Note: Locate well on Section Plat on reverse side)

CONTRACTOR: License # 6033
Name Murfin Drilling Co.
City/State Wichita, Kansas 67202

Nearest lease or unit boundary line 330 feet.
County Sheridan
Lease Name Brandt Farms Well# 1-26

Well Drilled For: Well Class: Type Equipment:
 Oil Swd Infield Mud Rotary
 Gas Inj Pool Ext. Air Rotary
 OWWO Expl Wildcat Cable

Domestic well within 330 feet: yes no
Municipal well within one mile: yes no

If OWWO: old well info as follows:
Operator
Well Name
Comp Date Old Total Depth
Projected Total Depth 4300 feet
Projected Formation at TD Arbuckle
Expected Producing Formations Lansing/Arbuckle

Depth to Bottom of fresh water 100 250 mhc feet
Lowest usable water formation Dakota
Depth to Bottom of usable water 1400 1200 feet
Surface pipe by Alternate: 1 2
Surface pipe to be set 250 270 mhc feet
Conductor pipe if any required N/A feet
Ground surface elevation 2,655 feet MSL
This Authorization Expires ~~2-6-85~~ 2-6-85
Approved By E. 8/84

I certify that we will comply with K.S.A. 55-101, et seq., plus eventually plugging hole to K.C.C. specifications. 1005: CNWSW 4620 F 54
1980 FSL


Date Signature of Operator or Agent Title Drilling/Production Engineer

mhc/KOME 8/9/84 Form C-1 4/84

Must be filed with the K.C.C. five (5) days prior to commencing well
 This card void if drilling not started within six (6) months of date received by K.C.C.

Important procedures to follow :

**A Regular Section of Land
 1 Mile = 5,280 Ft.**

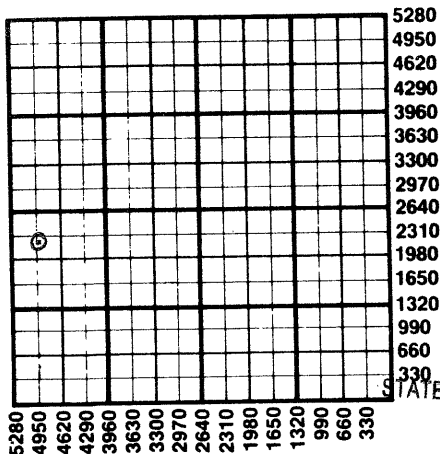

1. Notify District office before setting surface casing.
2. Set surface casing by circulating cement to the top.
3. File completion forms ACO-1 with K.C.C. within 90 days of well completion, following instructions on ACO-1, side 1, and including copies of wireline logs.
4. Notify District office 48 hours prior to old well workover or re-entry.
5. Prior to plugging, prepare a plugging plan, then obtain agreement from the appropriate district office for an approved plugging plan.
6. Submit plugging report (CP-4) to K.C.C. after plugging is completed.
7. Obtain an approved injection docket number before disposing of salt water.
8. Notify K.C.C. within 10 days when injection commences or terminates.

9. If an alternate 2 completion, cement in the production pipe from below
 into usable water to surface within 120 days of spud date.

RECEIVED
 STATE CORPORATION COMMISSION

AUG 09 1984
 8-9-84
 CONSERVATION DIVISION
 Wichita, Kansas

State Corporation Commission of Kansas
 Conservation Division
 200 Colorado Derby Building
 Wichita, Kansas 67202
 (316) 263-3238