

FOR KCC USE:

CORRECTED CORRECTED CORRECTED CORRECTED

FORM C-1 7/91

FORM MUST BE TYPED

FORM MUST BE SIGNED

ALL BLANKS MUST BE FILLED

EFFECTIVE DATE: 9-9-92
DISTRICT # 4
SGA? Yes X No

State of Kansas
NOTICE OF INTENTION TO DRILL

COR

Must be approved by the K.C.C. five (5) days prior to commencing well

Expected Spud Date September 9, 1992
month day year
* Spot SE SW NE Sec 23 Twp 6 S, Rg 26 East West

OPERATOR: License # 30407
Name: Black Petroleum Company
Address Box 12922
City/State/Zip: Wichita, Kansas, 67277
Contact Person: Thomas E. Black
Phone: 942-2741

* 3240 feet from South / North line of Section
* 1440 feet from East / West line of Section
IS SECTION X REGULAR IRREGULAR?
(NOTE: Locate well on the Section Plat on Reverse Side)
County: Sheridan
Lease Name: TEEL Well #: 1
Field Name: Vahling West
Is this a Prorated/Spaced Field? yes X no
Target Formation(s): Topeka-Lansing KC
* Nearest lease or unit boundary: 330'
Ground Surface Elevation: 2603 approx feet MSL
Water well within one-quarter mile: yes X no
Public water supply well within one mile: yes X no
Depth to bottom of fresh water: 300'
Depth to bottom of usable water: 1355'
Surface Pipe by Alternate: 1 X 2
Length of Surface Pipe Planned to be set: 356' 300'
Length of Conductor pipe required:
Projected Total Depth: 3900'
Formation at Total Depth: BS/Lansing-KC
Water Source for Drilling Operations:
... well ... farm pond ... X other

CONTRACTOR: License #: 5420
Name: White and Ellis Drilling Inc. Rig #9

Well Drilled For: Well Class: Type Equipment:
X Oil ... Enh Rec .X Infield .X Mud Rotary
... Gas ... Storage ... Pool Ext. ... Air Rotary
... OWWO ... Disposal ... Wildcat ... Cable
... Seismic; ... # of Holes ... Other
... Other

If OWWO: old well information as follows:
Operator:
Well Name:
Comp. Date: Old Total Depth

Directional, Deviated or Horizontal wellbore? yes X no
If yes, true vertical depth:

Bottom Hole Location
* Was 3070 ft + 1320 ft 5252 NE G.S.L. 2552'
N.L.B. 440 S. Casing Alt 2 356'

AFFIDAVIT
* IS 3240 ft. s. 1 + 1440 ft. S E SW NE
G.S.L. 2603 approx. Surface casing 300'
N.L.B. 330'

The undersigned hereby affirms that the drilling, completion and eventual plugging of this well will comply with K.S.A. 55-101, et. seq.

It is agreed that the following minimum requirements will be met:

- 1. Notify the appropriate district office prior to spudding of well;
- 2. A copy of the approved notice of intent to drill shall be posted on each drilling rig;
- 3. The minimum amount of surface pipe as specified below shall be set by circulating cement to the top; in all cases surface pipe shall be set through all unconsolidated materials plus a minimum of 20 feet into the underlying formation;
- 4. If the well is dry hole, an agreement between the operator and the district office on plug length and placement is necessary prior to plugging;
- 5. The appropriate district office will be notified before well is either plugged or production casing is cemented in;
- 6. IF AN ALTERNATE II COMPLETION, PRODUCTION PIPE SHALL BE CEMENTED FROM BELOW ANY USABLE WATER TO SURFACE WITHIN 120 DAYS OF SPUD DATE. IN ALL CASES, NOTIFY DISTRICT OFFICE PRIOR TO ANY CEMENTING.

I hereby certify that the statements made herein are true and to the best of my knowledge and belief.

Date: 9/9/92 Signature of Operator or Agent: Thomas E. Black Title: President

FOR KCC USE:
API # 15- 179-21049 -00-00
Conductor pipe required none feet
Minimum surface pipe required 300 feet per Alt. X
Approved by: C.B. 9-4-92
This authorization expires: 3-4-93
(This authorization void if drilling not started within 6 months of effective date.)
Spud date: Agent:

Cor 9/9/92 CB

REMEMBER TO:

- File Drill Pit Application (form CDP-1) with Intent to Drill;
- File Completion Form ACO-1 within 120 days of spud date;
- File acreage attribution plat according to field proration orders;
- Notify appropriate district office 48 hours prior to workover or re-entry;
- Submit plugging report (CP-4) after plugging is completed;
- Obtain written approval before disposing or injecting salt water.

Mail to: Conservation Division, 200 Colorado Derby Building, 202 W. First St., Wichita, Kansas 67202-1286.

23
6
26

IN ALL CASES PLOT THE INTENDED WELL ON THE PLAT BELOW

PLAT OF ACREAGE ATTRIBUTABLE TO A WELL IN A PRORATED OR SPACED FIELD

If the intended well is in a prorated or spaced field, please fully complete this side of the form. If the intended well is in a prorated or spaced field complete the plat below showing that the well will be properly located in relationship to other wells producing from the common source of supply. Please show all the wells within 1 mile of the boundaries of the proposed acreage attribution unit for gas wells and within 1/2 mile of the boundaries of the proposed acreage attribution unit for oil wells.

API NO. 15- 179-21049
 OPERATOR Black Petroleum Company
 LEASE #1 Teel
 WELL NUMBER #1
 FIELD Vahling West

LOCATION OF WELL: COUNTY Sheridan
 * 3240 feet from south/north line of section
 * 1440 feet from east/west line of section
 SECTION 23 TWP 6s RG 26w



NUMBER OF ACRES ATTRIBUTABLE TO WELL _____
 QTR/QTR/QTR OF ACREAGE _____ - _____ - _____

IS SECTION _____ REGULAR or _____ IRREGULAR
IF SECTION IS IRREGULAR, LOCATE WELL FROM NEAREST CORNER BOUNDARY.

Section corner used: _____ NE _____ NW _____ SE _____ SW

PLAT

(Show location of the well and shade attributable acreage for prorated or spaced wells.)
 (Show footage to the nearest lease or unit boundary line.)

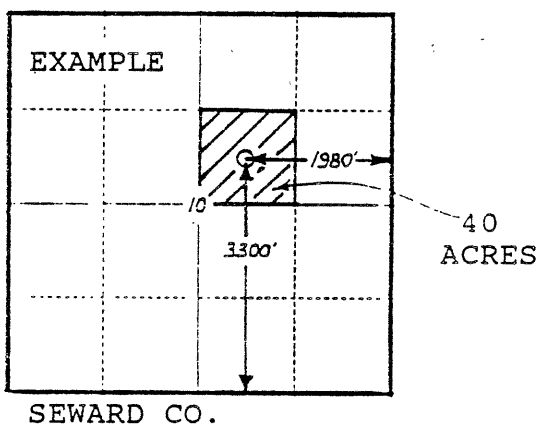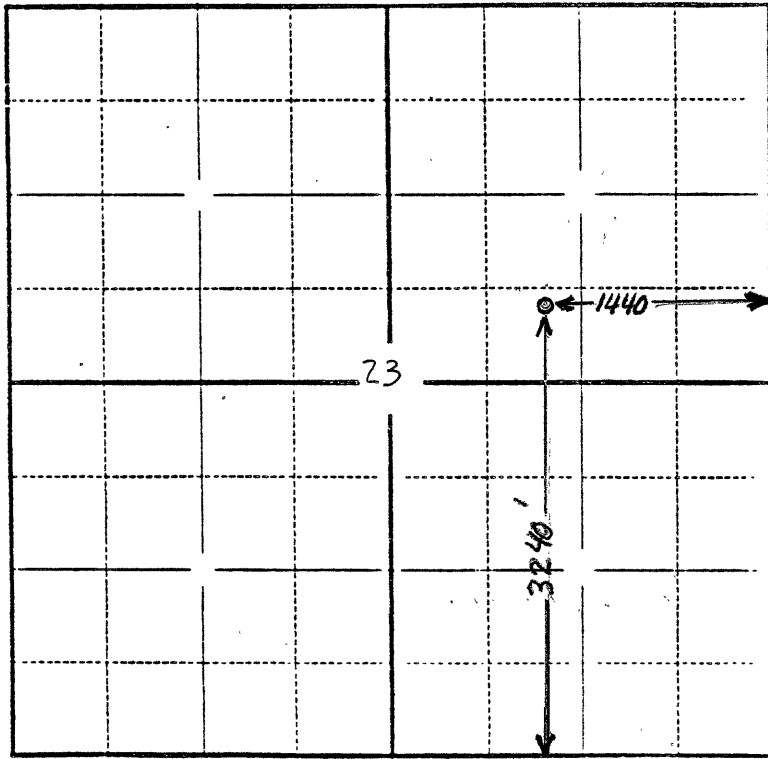

In plotting the proposed location of the well, you must show:

- 1) The manner in which you are using the depicted plat by identifying section lines, i.e. 1 section, 1 section with 8 surrounding sections, 4 sections, etc.;
- 2) the distance of the proposed drilling location from the section's south/north and east/west lines; and
- 3) the distance to the nearest lease or unit boundary line.