

CARD MUST BE TYPED

State of Kansas
NOTICE OF INTENTION TO DRILL
(see rules on reverse side)

CARD MUST BE SIGNED

Starting Date: 7 11 85
month day year

API Number 15- 179-20,834-00-00

OPERATOR: License # 5135
Name John O. Farmer, Inc.
Address P.O. Box 352
City/State/Zip Russell, KS 67665
Contact Person John O. Farmer III
Phone (913) 483-3144

..... East
NE. NE. SW. Sec 3 .. Twp 6 .. S, Rge 27. West
(location)

CONTRACTOR: License # 5135
Name John O. Farmer, Inc.
City/State Russell, KS 67665

..... 2310 Ft North from Southeast Corner of Section
..... 2970 Ft West from Southeast Corner of Section
(Note: Locate well on Section Plat on reverse side)

Well Drilled For: Well Class: Type Equipment:
 Oil Swd Infield Mud Rotary
 Gas Inj Pool Ext. Air Rotary
 OWWO Expl Wildcat Cable

Nearest lease or unit boundary line 330 feet.
County Sheridan
Lease Name Johnson Well# 1

If OWWO: old well info as follows:
Operator
Well Name
Comp Date Old Total Depth
Projected Total Depth 3880 feet
Projected Formation at TD Lansing/KC
Expected Producing Formations Lansing/KC

Domestic well within 330 feet: yes no
Municipal well within one mile: yes no
Production string will be cemented from Anhy. to surface upon completion of well.
Depth to Bottom of fresh water 100 feet
Lowest usable water formation Dakota
Depth to Bottom of usable water 1450 1300 feet
Surface pipe by Alternate: 1 2
Surface pipe to be set 220 feet
Conductor pipe if any required none feet
Ground surface elevation 2540 Est. feet MSL
This Authorization Expires 1-9-86
Approved By 79-85 R

I certify that we will comply with K.S.A. 55-101, et seq., plus eventually plugging hole to K.C.C. specifications.

Date 7-8-85 Signature of Operator or Agent

John O. Farmer III

Title Vice-president

RCH FOR KDHE

Must be filed with the K.C.C. five (5) days prior to commencing well
This card void if drilling not started within six (6) months of date received by K.C.C.


RECEIVED
STATE CORPORATION COMMISSION

7-9-85

Important procedures to follow :

A Regular Section of Land
1 Mile = 5,280 Ft.

CONSERVATION DIVISION
Wichita, Kansas

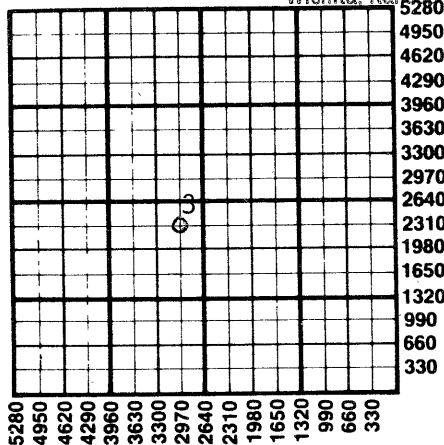

1. Notify District office before setting surface casing.
2. Set surface casing by circulating cement to the top.
3. File completion forms ACO-1 with K.C.C. within 90 days of well completion, following instructions on ACO-1, side 1, and including copies of wireline logs.
4. Notify District office 48 hours prior to old well workover or re-entry.
5. Prior to plugging, prepare a plugging plan, then obtain agreement from the appropriate district office for an approved plugging plan.
6. Submit plugging report (CP-4) to K.C.C. after plugging is completed.
7. Obtain an approved injection docket number before disposing of salt water.
8. Notify K.C.C. within 10 days when injection commences or terminates.
9. If an alternate 2 completion, cement in the production pipe from below any usable water to surface within 120 days of spud date.

State Corporation Commission of Kansas
Conservation Division
200 Colorado Derby Building
Wichita, Kansas 67202
(316) 263-3238