


15-179-00039-00-00

STATE OF KANSAS
STATE CORPORATION COMMISSION

Give All Information Completely
Make Required Affidavit
Mail or Deliver Report to:
Conservation Division
State Corporation Commission
800 Bitting Building
Wichita, Kansas

WELL PLUGGING RECORD

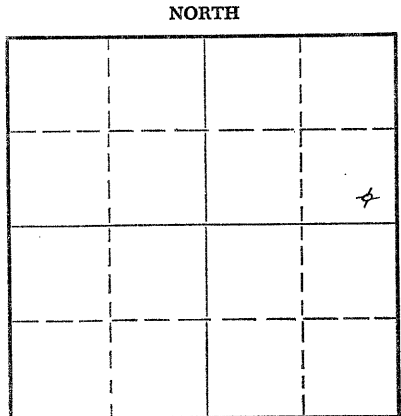

Locate well correctly on above
Section Plat

Sheridan County. Sec. 4 Twp. 6S Rge. 27 (E) W (W)
Location as "NE/CNW/SW" or footage from lines C SE 1/4 SE 1/4 NE 1/4
Lease Owner The Derby Oil Company
Lease Name Muirhead Well No. 1
Office Address P.O. Box 1030, Wichita, Kansas
Character of Well (completed as Oil, Gas or Dry Hole) Dry Hole
Date well completed Oct. 25 19 53
Application for plugging filed Oct. 25 19 53
Application for plugging approved Oct. 25 19 53
Plugging commenced Oct. 25 19 53
Plugging completed Oct. 25 19 53
Reason for abandonment of well or producing formation Dry Hole

If a producing well is abandoned, date of last production _____ 19____
Was permission obtained from the Conservation Division or its agents before plugging was commenced? Yes

Name of Conservation Agent who supervised plugging of this well Eldon Petty
Producing formation _____ Depth to top _____ Bottom _____ Total Depth of Well 389 1/2 Feet
Show depth and thickness of all water, oil and gas formations.

OIL, GAS OR WATER RECORDS

CASING RECORD

FORMATION	CONTENT	FROM	TO	SIZE	PUT IN	PULLED OUT
		0	223'	8 5/8"	223'	None

Describe in detail the manner in which the well was plugged, indicating where the mud fluid was placed and the method or methods used in introducing it into the hole. If cement or other plugs were used, state the character of same and depth placed, from _____ feet to _____ feet for each plug set.

From 389 1/2' to 211 1/2' - heavy rotary mud
211 1/2' to 210' - wooden plug
210' to 164' - 15 sacks cement & 1/2 sack hulls
164' to 41 1/2' - heavy rotary mud
41 1/2' to 40' - wooden plug
40' to 6' - 10 sacks cement & 1/2 sack hulls
6' to surface - cellar

11-5-53

Name of Plugging Contractor Glenn W. Peel
Address P.O. Box 359, Hoisington, Kansas


STATE OF KANSAS, COUNTY OF BARTON, ss.
Glenn W. Peel (employee of owner) or (owner or operator) of the above-described well, being first duly sworn on oath, says: That I have knowledge of the facts, statements, and matters herein contained and the log of the above-described well as filed and that the same are true and correct. So help me God. GLENN W. PEEL

(Signature) BY: [Signature]
P.O. Box 359, Hoisington, Kansas
(Address)

SUBSCRIBED AND SWORN TO before me this 27th day of October 19 53
[Signature] Notary Public.

My commission expires 1-11-55

24-7868-S 3-53-20M

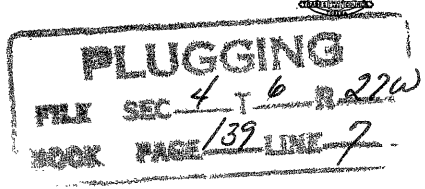

DRILLER'S LOG

Company: The Derby Oil Company
Farm Name: Muirhead Well No. 1
Depth: 3894
Comm: 10-15-53 Comp: 10-25-53
Contractor: Glenn W. Peel
Casing: 8 5/8" - 223' cem.

C. SE 1/4 SE 1/4 NE 1/4
Sec. 4, Twp. 6S, Rge. 27 W,
County: Sheridan,
Kansas
Elevation:
Production: Dry

Figures below indicate bottoms of formations:

Shale	0 -	125
Sand		175
Shale and sand		225
Shale and Shells		300
Shale and sand		1370
Shale and shells		1765
Anhydrite		1805
Shale and shells		2240
Lime and shale		2360
Shale and shells		2750
Shale and lime		3175
Lime		3894
Total Depth		3894

This is to certify that the above information is to the best of our knowledge, true and correct.

GLENN W. PEEL

BY: *John R. Matthews*

SUBSCRIBED AND SWORN to before me this 29 day of October, 1953.

My Commission expires 1-11-55

Sigrid K. Lewis
Notary Public

REGISTERED
SHERIDAN COUNTY, KANSAS

PLUGGING
BOOK PAGE 139