


15-179-05265-0000

STATE OF KANSAS
STATE CORPORATION COMMISSION
CONSERVATION DIVISION
P. O. BOX 17027
WICHITA, KANSAS 67217

WELL PLUGGING RECORD

Sheridan County. Sec. 11 Twp. 6 Rge. (E) 27 (W)
Location as "NE/CNW&SWK" or footage from lines. SE NE NE
Lease Owner Continental Oil Company
Lease Name Adell Lansing KC Unit Well No. 306
Office Address Box 267, Great Bend, Kansas 67530
Character of Well (completed as Oil, Gas or Dry Hole) oil
Date well completed _____ 19____
Application for plugging filed Nov. 3 1975
Application for plugging approved _____ 19____
Plugging commenced Nov. 17 1975
Plugging completed Jan. 5 1976
Reason for abandonment of well or producing formation depleted

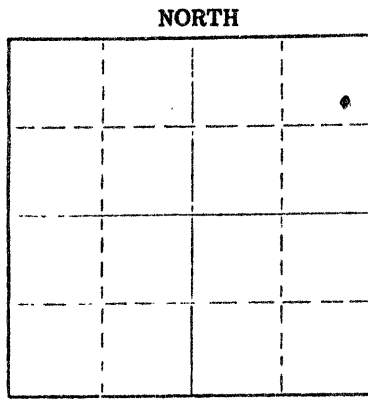

Locate well correctly on above Section Plat

If a producing well is abandoned, date of last production _____ 19____
Was permission obtained from the Conservation Division or its agents before plugging was commenced? yes

Name of Conservation Agent who supervised plugging of this well Gilbert Balthazor
Producing formation _____ Depth to top _____ Bottom _____ Total Depth of Well 3870 Feet
Show depth and thickness of all water, oil and gas formations.

OIL, GAS OR WATER RECORDS				CASING RECORD		
FORMATION	CONTENT	FROM	TO	SIZE	PUT IN	PULLED OUT
			281'	10 3/4"	281'	none
			3901'	6"	3901'	1032.88

Describe in detail the manner in which the well was plugged, indicating where the mud fluid was placed and the method or methods used in introducing it into the hole. If cement or other plugs were used, state the character of same and depth placed, from _____ feet to _____ feet for each plug set.

Sanded back to 3575' and dumped 5 sacks of cement.
Sun Cementing Company plugged well pumping in 5 sacks of hulls, 16 sacks of gel and 150 sacks of cement.

(If additional description is necessary, use BACK of this sheet)
Name of Plugging Contractor PIPE PULLERS, INC.
Address Box 128, Ellinwood, Kansas 67526

STATE OF KANSAS COUNTY OF BARTON ss.
Evelyn Roth (employee of owner) or (owner or operator) of the above-described well, being first duly sworn on oath, says: That I have knowledge of the facts, statements, and matters herein contained and the log of the above-described well as filed and that the same are true and correct. So help me God.

(Signature) Evelyn Roth
Ellinwood, Kansas
(Address)

SUBSCRIBED AND SWORN TO before me this 20th day of January, 1976

My commission expires _____
JENNY KASSELMAN
NOTARY PUBLIC
BARTON COUNTY, KANSAS
MY COMM. EXP. JULY 16, 1973

Jenny Kasselmann
Notary Public.

RECEIVED
STATE CORPORATION COMMISSION
1-21-76
JAN 21 1976
CONSERVATION DIVISION
Wichita, Kansas