

15-179-05261-00-00

STATE OF KANSAS
STATE CORPORATION COMMISSION

WELL PLUGGING RECORD


OR

FORMATION PLUGGING RECORD

Strike out upper line when reporting plugging of formations.

Give All Information Completely
Make Required Affidavit
Mail or Deliver Report to:
Conservation Division
State Corporation Commission
800 Biting Building
Wichita, Kansas

Rooks County. Sec. 11 Twp. 6S Rge. 27 (W)
Location as "NE 1/4 NW 1/4 SW 1/4" or footage from lines NE SE NW
Lease Owner Derby Oil Company
Lease Name Bouts Well No. 1
Office Address 420 West Douglas, Wichita, Kansas.
Character of Well (completed as Oil, Gas or Dry Hole) Dry hole
Date well completed February 16, 1949
Application for plugging filed March 28, 1949
Application for plugging approved March 29, 1949
Plugging commenced April 13, 1949
Plugging completed April 21, 1949
Reason for abandonment of well or producing formation Dry Hole

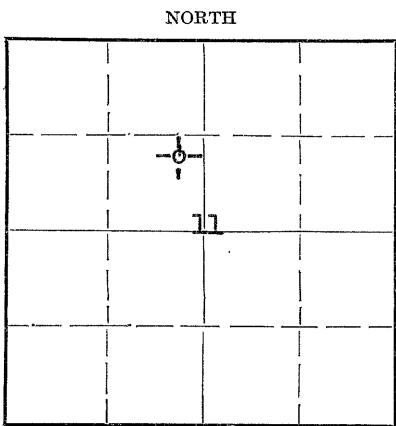

Locate well correctly on above Section Plat

If a producing well is abandoned, date of last production None 19
Was permission obtained from the Conservation Division or its agents before plugging was commenced? Yes

Name of Conservation Agent who supervised plugging of this well Mr. Petty
Producing formation None Depth to top Bottom Total Depth of Well 3837 Feet
Show depth and thickness of all water, oil and gas formations.

OIL, GAS OR WATER RECORDS

CASING RECORD

Formation	Content	From	To	Size	Put In	Pulled Out
				5 1/2"	3836	1115'
				8 5/8"	294	None

Describe in detail the manner in which the well was plugged, indicating where the mud fluid was placed and the method or methods used in introducing it into the hole. If cement or other plugs were used, state the character of same and depth placed, from feet to feet for each plug set.

Rocked hole to 3600'. Run 5 sacks cement.
Mudded hole to 290'. Run 15 sacks of cement.
Mudded hole to 20' of top. Run 10 sacks of cement.
Well Completed

RECEIVED
MAY 4 - 1949
STATE CORPORATION COMMISSION
KANSAS
9-4-49

(If additional description is necessary, use BACK of this sheet)

Correspondence regarding this well should be addressed to Derby Oil Company
Address Box 1030, Wichita, Kansas,

STATE OF Kansas, COUNTY OF Sedgwick, ss.
J. R. Bratcher (employee of owner) of the above-described well,
being first duly sworn on oath, says: That I have knowledge of the facts, statements, and matters herein contained and the log of the above-described well as filed and that the same are true and correct. So help me God.

(Signature) J. R. Bratcher
Derby Oil Company, Wichita, Kansas.
(Address)

SUBSCRIBED AND SWORN to before me this 3rd day of May, 1949

My commission expires June 11, 1952

Ruth L. Krause
Ruth L. Krause, Notary Public.

PLUGGING
FILE SEC 11 T 6 R 276
BOOK PAGE 88 LINE 30

DRILLER'S LOG

Company: Derby Oil Company
Peel-Mardian Producers
R. C. McCormick
R. W. Shields
W. L. Leidig

Sec. 11 Twp. 6S Rgv. 27N
NE 28.34

County: Sheridan
Kansas

Farm: Bouts Well No. 1
Total Depth: 3837 (Rotary)
Comm.: 2-7-49 Comp.: 2-16-49
Contractor: Glenn Peel Drilling Co., Inc.
Casing:
3 5/8" 294' con.
3 1/2" 3543' con.

Elevation:

Production:

Figures below indicate bottom of formations

Sand and Shale	0 -	294
Shale		1137
Sand		1337
Shale and Shells		1563
Anhydrite		1736
Shale and Shells Bracks		2120
Line		2283
Shale		2333
Shale and Shells		2533
Line and Shale		2940
Shale and Line		3010
Line		3115
Line and Shale		3300
Line		3600
Line and Shale		3734
Cherty Line		3755
Line		3820
Cherty Line		3837
Total Depth		3837

This is to certify that the above information is, to the best of our knowledge, true and correct.

RECORDED

Correlation Div.

GLENN PEEL DRILLING COMPANY, INC.

STATE CORPORATION

20% COMMISSION

BY:

Mendell E. Peel

KANSAS

5-4-49

SUBSCRIBED AND SWORN to before me this 10th day of February, 1949

My commission expires June 3, 1951

Marian M. Hefert
Notary Public

PLUGGING
FILE SEC 11 T 6 R 276
BOOK PAGE 89 LINE 30