


15-179-05162-00-00

STATE OF KANSAS  
STATE CORPORATION COMMISSION

WELL PLUGGING RECORD

Give All Information Completely  
Make Required Affidavit  
Mail or Deliver Report to  
Conservation Division  
State Corporation Comm.  
245 North Water  
Wichita, KS 67202

Sheridan County, Sec. 12 Twp. 6 Rge. 27 E/W  
Location as "NE/CNW $\frac{1}{4}$ SW $\frac{1}{4}$ " or footage from lines  
NW NW SE  
Lease Owner Petroleum Management, Inc.  
Lease Name Adell #206 Well No.  
Office Address Great Bend, Kansas 67530  
Character of Well (Completed as Oil, Gas or Dry Hole)

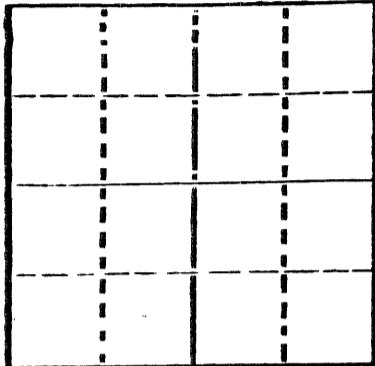

Locate well correctly on above  
Section Plat

Date Well completed 19  
Application for plugging filed 19  
Application for plugging approved 19  
Plugging commenced 6/5/76 19  
Plugging completed 6/10/76 19  
Reason for abandonment of well or producing formation  
depleted.

If a producing well is abandoned, date of last production 19

Was permission obtained from the Conservation Division or  
its agents before plugging was commenced? yes

Name of Conservation Agent who supervised plugging of this well Balthazor  
Producing formation Depth to top Bottom Total Depth of Well 3828  
Show depth and thickness of all water, oil and gas formations.

OIL, GAS OR WATER RECORDS

CASING RECORD

| FORMATION | CONTENT | FROM | TO | SIZE   | PUT IN | PULLED OUT |
|-----------|---------|------|----|--------|--------|------------|
|           |         |      |    | 8-5/8  | 220    | none       |
|           |         |      |    | 5 1/2" | 3828   | 1323'      |

Describe in detail the manner in which the well was plugged, indicating where the mud fluid  
was placed and the method or methods used in introducing it into the hold. If cement or other  
plugs were used, state the character of same and depth placed, from feet to  
feet for each plug set.

Checked hole, sanded to 3625' and ran 5 sacks cement. Shot pipe at  
1520', 1415', 1315', pulled 41 joints. Squeezed well with 3 sacks  
hulls, 70 sacks cement, 17 sacks gel, released plug and displaced  
with 60 sacks cement.

PLUGGING COMPLETE.

RECEIVED  
STATE CORPORATION COMMISSION

JUN 17 1976

6-17-76

RECEIVED AT BEND  
WICHITA, KANSAS

(If additional description is necessary, use BACK of this sheet)

Name of Plugging Contractor KELSO CASING PULLING  
CHASE, KANSAS


STATE OF KANSAS COUNTY OF RICE  
R. DARRELL KELSO (employee of owner) or (owner or operator) of the above-described  
well, being first duly sworn on oath, says: That I have knowledge of the facts, statements, and matters herein contained and the log of the  
above-described well as filed and that the same are true and correct. So help me God.

(Signature) R. Darrell Kelso  
CHASE, KANSAS

(Address)

Subscribed and sworn to before me this day of 19

My commission expires

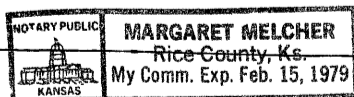

Margaret Melcher  
Notary Public