

Notice: Fill out COMPLETELY and return to Conservation Division at the address below within 60 days from plugging date.

KANSAS CORPORATION COMMISSION
OIL & GAS CONSERVATION DIVISION
WELL PLUGGING RECORD
K.A.R. 82-3-117

Form CP-4
December 2003
Type or Print on this Form
Form must be Signed
All blanks must be Filled

Lease Operator: Oil Producers Inc. of KS
Address: 1710 Waterfront Pkwy Wichita KS 67206
Phone: (316) 681-0231 Operator License #: KS 8061
Type of Well: SWD Docket #: _____
(Oil, Gas D&A, SWD, ENHR, Water Supply Well, Cathodic, Other) (If SWD or ENHR)
The plugging proposal was approved on: 03/28/05 (Date)
by: STEVE DURANT (KCC District Agent's Name)
Is ACO-1 filed? Yes No If not, is well log attached? Yes No
Producing Formation(s): List All (If needed attach another sheet)
LKC / w CIBP @ Depth to Top: Back Bottom: 4113 T.D. 3979'
LKC Depth to Top: _____ Bottom: _____ T.D. _____
LKC Depth to Top: _____ Bottom: _____ T.D. _____

API Number: 15-093-10002-00-01
Lease Name: LEE A
Well Number: A#1 SWD
Spot Location (QQQQ): C - NE - NE
4620 Feet from North / South Section Line
660 Feet from East / West Section Line
Sec. 33 Twp. 25 S. R. 36 East West
County: KEARNY
Date Well Completed: 10/57 (original well)
Plugging Commenced: 03/28/05
Plugging Completed: 03/31/05

Show depth and thickness of all water, oil and gas formations.

Oil, Gas or Water Records		Casing Record (Surface Conductor & Production)				
Formation	Content	From	To	Size	Put In	Pulled Out
		Surf	560'	13 3/8	1957 yr drilled	
		Surf	2250'	8 5/8 2 1/2"	1957 yr drilled	530' / 2005
		Surf	5070'	5 1/2 1 7/8"	1957 yr drilled	2000' / 2005

Describe in detail the manner in which the well is plugged, indicating where the mud fluid was placed and the method or methods used in introducing it into the hole. If cement or other plugs were used, state the character of same depth placed from (bottom), to (top) for each plug set.


TUBING PARTS @ 2260' SET CIBP @ 2255' w/ 25SKS Cement Cut 5 1/2 @ 2000'
PULLED & LOG DOWN - SET 8 5/8 CIBP @ 1800' RUN CBL - TOC @ 550' SHOOT
& CUT 8 5/8 @ 530' PULL & LOG DOWN 8 5/8 RUN TUBING TO 530' MIX & SPOT 60 SKS
60/40 & SPOT. PULL TO 90' MIX & SPOT 40 SKS 60/40 & SPOT HOLE STRAPS FULL PUT & CAP

Name of Plugging Contractor: TR Service & Repair / Alliance Well Serv. License #: 3334L
Address: 271 Lake Ross Pratt KS
Name of Party Responsible for Plugging Fees: Oil Producers Inc

RECEIVED
MAY 12 2005

State of _____ County, _____, ss. _____
(Employee of Operator) or (Operator) on above-described well being plugged,
sworn on oath, says: That I have knowledge of the facts statements, and matters herein contained, and the log of the above-described well is as filed, and the same are true and correct, so help me God.

(Signature) [Signature]
(Address) 271 Lake Ross Pratt KS 67124

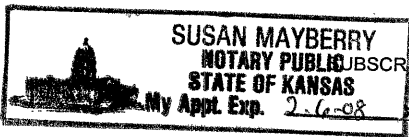


Subscribed and SWORN TO before me this _____ day of _____, 20____
Notary Public [Signature] My Commission Expires: 2-6-08

Mail to: KCC - Conservation Division, 130 S. Market - Room 2078, Wichita, Kansas 67202

See Reverse for Well Diagram

[Signature]

LEE A#1 SWD

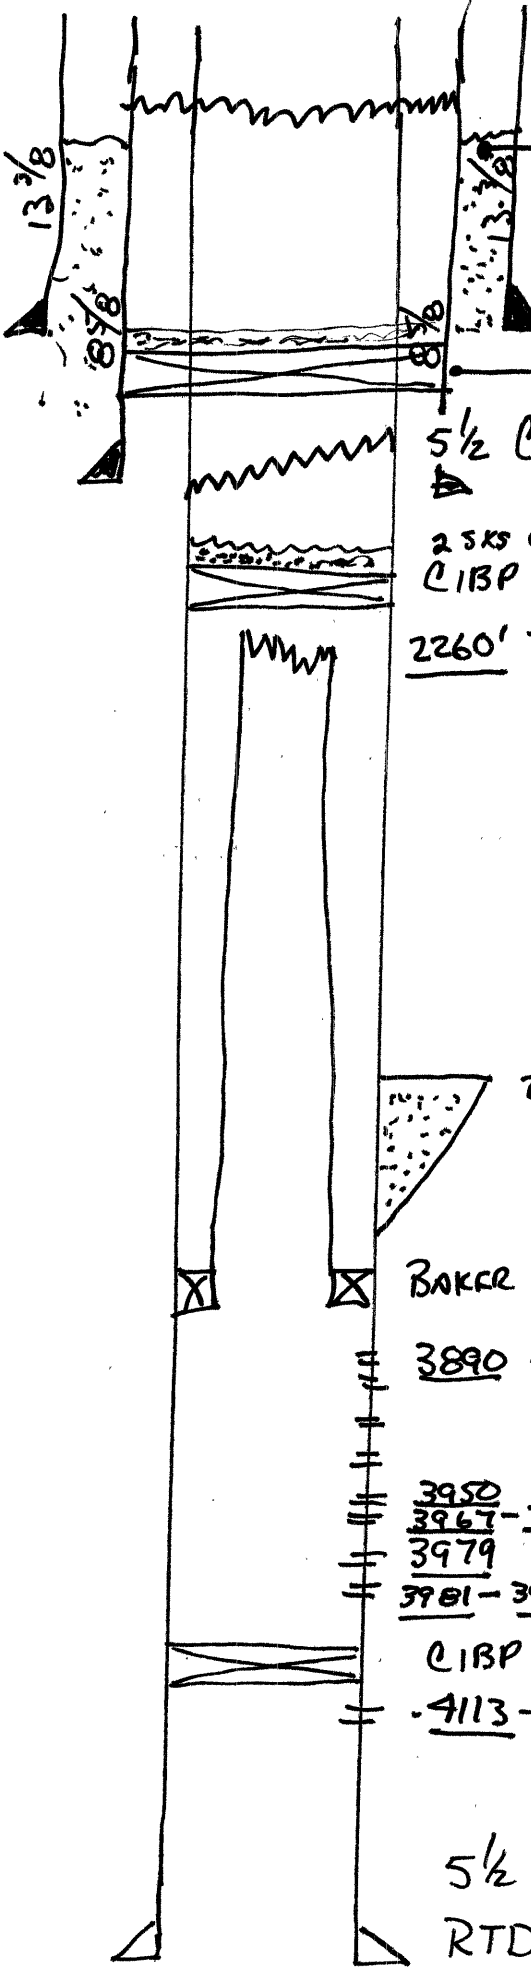

16' KB

TOP OF CEMENT 550'

8 5/8 Cut off @ 530'
+ Pullers -

8 5/8 CIBP w/ 2SKS CEMENT @ 1800'

5 1/2 CUT OFF @ 2000' + PULLERS.

2 SKS CEMENT
CIBP @ 2255'

2260' TOP OF FISH 2 3/8 EUE

2875' TOC / Squeeze 1962

BAKER AD-1 Set @ 3753'

3890 LKC

3950 LKC

3967-77' LKC

3979 LKC

3981-3991' LKC

CIBP @ 4022'

4113- LKC

5 1/2 17" SET @ 5070' w 125 SKS

RTD 5070'

* Run 2 3/8 To 530' @ 8 5/8

Cut-off - Spot 60SK 60/40 Ptz

Pull to 90' Spot 40SKS 60/40 Ptz

Lay Down Tubing - Weld Cap on

13 3/8 Cut off @ 6' Below G.L.

Clear Location + fill All

Pits/Cellars + Pump feet

Water in Lead Line -

To Flush ALL S. Water RDMO

ELI Loopers

Allard Cementers

Alliance Rig

Shawnee Kousstabout

By

TERRY RICHARDSON

785-623-1066