

CARD MUST BE TYPED

State of Kansas  
NOTICE OF INTENTION TO DRILL  
HUGOTON INFILL

CARD MUST BE SIGNED

SGA-YCS

EFFECTIVE DATE 5-18-05

Starting Date MAY 01 2005  
month day year

API Number 15- 187-21057-00-00

IS SECTION X REGULAR IRREGULAR

OPERATOR: License # 5952 (6-30-05)

Name BP AMERICA PRODUCTION COMPANY  
Address P. O. BOX 3092, WL1, RM 3.201  
City/State/Zip HOUSTON, TX 77253-3092  
Contact Person SUE SELLERS  
Phone (281)366-2052

CSE SE NE Sec 03 Twp 29 S, Rg 40 W W  
2310 FNL Ft. from South Line of Section  
330 FEL Ft. from East Line of Section

Note: Attach acreage attribution plat locating both Chase (Hugoton) wells  
Total number of acres attributed to unit 640

CONTRACTOR License # 5382 33375 (2-28-06)  
Name CHEYENNE DRILLING LP  
City/State

Nearest producing well from same common source of supply 2160 feet  
Nearest lease or unit boundry line 330 feet  
County STANTON

Well Drilled as: X New Recompletion OWWO  
Projected Total Depth 2600 feet

Lease Name DOTTER Well # 3HI  
Ground surface elevation 3274 feet MSL

Formation  
If OWWO or Recompletion: old well info as follows:

Depth to bottom of fresh water 640  
Depth to bottom of usable water 700

Operator  
Well Name  
Comp. Date Old Total Depth

Surface pipe by Alternate: 1 2 X  
Surface pipe planned to be set 660'  
Water Source for Drilled Operations:  
DWR Permit #: well farm pond X other

I certify that well will comply with K.S.A. 55-101, et seq., plus eventually plugging hole to KCC specifications.

Date MARCH 24, 2005 Signature of Operator or Agent

*Jan Dany*

PERMITTING COORDINATOR

For KCC Use:

Conductor Pipe Required NONE feet; Minimum Surface Pipe Required 660 feet per Alt. 42

This Authorization Expires 11-13-05 Approved By RPS-13-05


9/95

\* WELL LOC. EXCEPTION US-CONS. 229. C... GRANTED 5.13-05

Must be filed with K.C.C. five (5) days prior to commencing well  
This card void if drilling not started within six (6) months of date received by K.C.C.

RECEIVED  
KANSAS CORPORATION COMMISSION  
APR 01 2005  
CONSERVATION DIVISION  
WICHITA, KS

A Regular Section of Land  
1 Mile = 5,280 Ft.

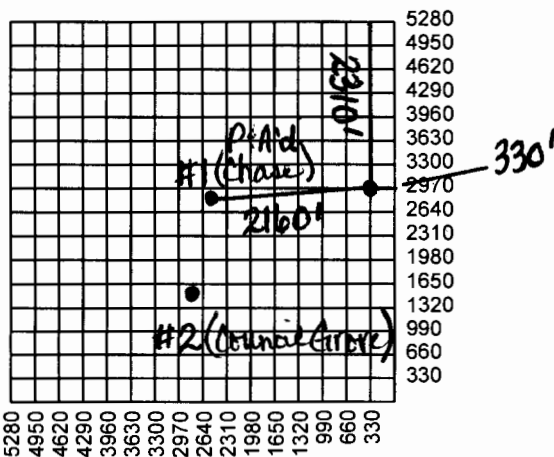

Important procedures to follow:

1. Notify District office before setting surface casing.
2. Set surface casing by circulating cement to the top.
3. File completion forms ACO-1 with K.C.C. within 120 days of well spud date, following instructions on ACO-1, side 1, and including copies of wireline logs.
4. Notify District office 48 hours prior to old well workover or re-entry.
5. Submit plugging report (CP-4) to K.C.C. after plugging is completed.
6. If an alternate 2 completion, cement in the production pipe from below any useable water to surface within 120 day of spud date.

State Corporation Commission of Kansas  
Conservation Division  
130 S. Market Room 2078  
Wichita, Kansas 67202-1212  
(316) 337-6231