

CARD MUST BE TYPED

State of Kansas  
NOTICE OF INTENTION TO DRILL  
HUGOTON INFILL

CARD MUST BE SIGNED

SCA-NO

EFFECTIVE DATE 5-21-05

Starting Date 05 01 2005  
month day year

API Number 15- 055-21876-0000  
IS SECTION  REGULAR  IRREGULAR

OPERATOR: License # 5952  
Name BP AMERICA PRODUCTION COMPANY  
Address P. O. BOX 3092, WLL, RM 3.201  
City/State/Zip HOUSTON, TX 77253-3092  
Contact Person SUE SELLERS  
Phone (281) 366-2052

NE NE SE Sec 27 Twp 23 S. Rg 33 W  
2320 FSL Ft. from South Line of Section  
150 FEL Ft. from East Line of Section

CONTRACTOR License # 5282-33375 (2-28-05)  
Name CHEYENNE DRILLING LP  
City/State \_\_\_\_\_

Note: Attach acreage attribution plat locating both Chase (Hugoton) wells  
Total number of acres attributed to unit 640

Well Drilled as:  New  Recompletion  OWWO  
Projected Total Depth 2800 feet  
Formation \_\_\_\_\_

Nearest producing well from  
same common source of supply 2397 feet  
Nearest lease or unit boundary line 150 feet

If OWWO or Recompletion: old well info as follows:  
Operator \_\_\_\_\_  
Well Name \_\_\_\_\_  
Comp. Date \_\_\_\_\_ Old Total Depth \_\_\_\_\_

County FINNEY  
Lease Name GARDEN CITY 3 Well # 2HI  
Ground surface elevation 2892 feet MSL  
Depth to bottom of fresh water 380  
Depth to bottom of usable water 1050  
Surface pipe by Alternate: 1-2 X  
Surface pipe planned to be set 400' MIN.  
Water Source for Drilled Operations:  
DWR Permit #: \_\_\_\_\_ well \_\_\_\_\_ farm pond  other \_\_\_\_\_

I certify that well will comply with K.S.A. 55-101, et seq., plus eventually plugging hole to KCC specifications.

Date 04-14-05 Signature of Operator or Agent Lou Barry Title PERMITTING COORDINATOR

For KCC Use:

Conductor Pipe Required NONE feet; Minimum Surface Pipe Required 400 feet per Alt. 1-2  
This Authorization Expires 11-17-05 Approved By RJP 5-17-05

9/95


**WELL LOCATION EXCEPTION GRANTED 5-17-05**  
**05-CONS-245-LWLE**

Must be filed with K.C.C. five (5) days prior to commencing well  
This card void if drilling not started within six (6) months of date received by K.C.C.

**RECEIVED**  
**KANSAS CORPORATION COMMISSION**  
**APR 20 2005**

**CONSERVATION DIVISION**  
**WICHITA, KS**

A Regular Section of Land  
1 Mile = 5,280 Ft.

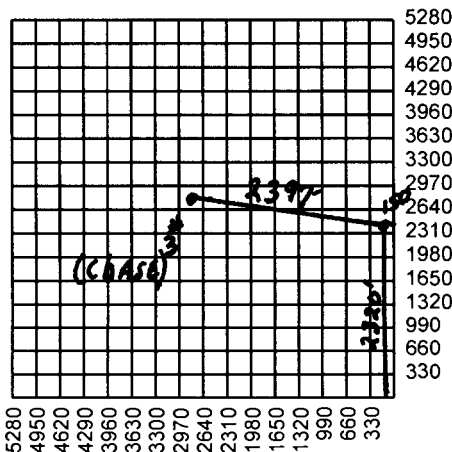

Important procedures to follow:

1. Notify District office before setting surface casing.
2. Set surface casing by circulating cement to the top.
3. File completion forms ACO-1 with K.C.C. within 120 days of well spud date, following instructions on ACO-1, side 1, and including copies of wireline logs.
4. Notify District office 48 hours prior to old well workover or re-entry.
5. Submit plugging report (CP-4) to K.C.C. after plugging is completed.
6. If an alternate 2 completion, cement in the production pipe from below any useable water to surface within 120 day of spud date.

State Corporation Commission of Kansas  
Conservation Division  
130 S. Market Room 2078  
Wichita, Kansas 67202-1212  
(316) 337-6231