

CARD MUST BE TYPED

KCC DIST #1

State of Kansas

CARD MUST BE SIGNED

NOTICE OF INTENTION TO DRILL
HUGOTON INFILL

SGA-No

EFFECTIVE DATE 5.30.05

Starting Date MAY 01 2005
month day year

API Number 15- 093-21769-00-00

IS SECTION X REGULAR IRREGULAR

OPERATOR: License # 5952 (6.30.05)
Name BP AMERICA PRODUCTION COMPANY
Address P. O. BOX 3092, W11, RM 3.201
City/State/Zip HOUSTON, TX 77253-3092
Contact Person SUE SELLERS
Phone (281) 366-2052

SE SE SW SW Sec 17 Twp 23S S, Rg 35W W
200' FSL Ft. from South Line of Section
1250' FWL Ft. from East Line of Section

Note: Attach acreage attribution plat locating both Chase (Hugoton) wells
Total number of acres attributed to unit 640

CONTRACTOR License # 33375 (2-28-06)
Name CHEYENNE DRILLING LP
City/State

Nearest producing well from same common source of supply 2947 feet
Nearest lease or unit boundary line 200' feet

Well Drilled as: X New Recompletion OWWO
Projected Total Depth 2820 feet
Formation

County KEARNY
Lease Name JPO GRABER Well # 2HI
Ground surface elevation 3047 feet MSL

IFOWWO or Recompletion: old well info as follows:

Operator
Well Name
Comp. Date Old Total Depth

Depth to bottom of fresh water 230
Depth to bottom of usable water 920
Surface pipe by Alternate: 1 - 2 X
Surface pipe planned to be set 250' min
Water Source for Drilled Operations:
DWR Permit #: well farm pond X other

I certify that well will comply with K.S.A. 55-101, et seq., plus eventually plugging hole to KCC specifications.

Date 04-20-05 Signature of Operator or Agent Lou Barry Title

PERMITTING COORDINATOR

For KCC Use:

Conductor Pipe Required NONE feet; Minimum Surface Pipe Required 250' feet per Alt. +2
This Authorization Expires 11.25.05 Approved By RJPS 25.05

9/95


WELL LOCATION EXCEPTION GRANTED 5.19.2005

Must be filed with K.C.C. five (5) days prior to commencing well
This card void if drilling not started within six (6) months of date received by K.C.C.

RECEIVED
KANSAS CORPORATION COMMISSION
APR 21 2005
CONSERVATION DIVISION
WICHITA, KS

OS-CONS 247 CWLE

A Regular Section of Land
1 Mile = 5,280 Ft.

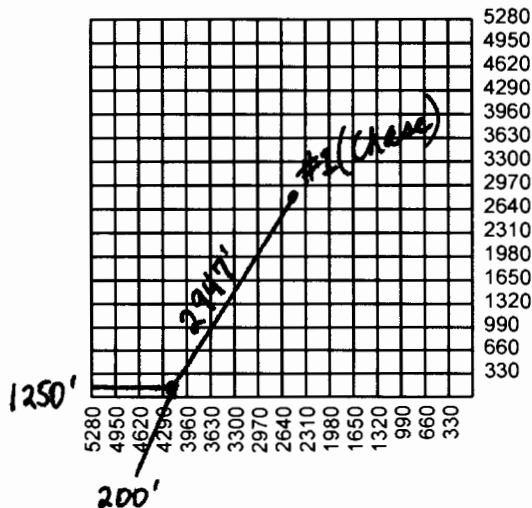

Important procedures to follow:

1. Notify District office before setting surface casing.
2. Set surface casing by circulating cement to the top.
3. File completion forms ACO-1 with K.C.C. within 120 days of well spud date, following instructions on ACO-1, side 1, and including copies of wireline logs.
4. Notify District office 48 hours prior to old well workover or re-entry.
5. Submit plugging report (CP-4) to K.C.C. after plugging is completed.
6. If an alternate 2 completion, cement in the production pipe from below any useable water to surface within 120 day of spud date.

State Corporation Commission of Kansas
Conservation Division
130 S. Market Room 2078
Wichita, Kansas 67202-1212
(316) 337-6231